

SURVEY &
REMONUMENTATION

DEC 07 1993

COMMISSIONER

LAND CORNER RECORDATION CERTIFICATE
Filing Requirement of Act 74, Mich. P.A. 1970

Approved By Delta County
Land Survey Remonumentation
Peer Group Under Act 345 Of
P.A. Of 1990 On October 21, 1993
Walter C. Thomson
Chairman

For corners in
DELTA
(County)

Located In: Corner Code #

- | | | |
|------------------------------------|-----------------------------|-------------------------|
| 1. Public Land Survey | T <u>39</u> N R <u>23</u> W | <u>K-7</u> & <u>L-9</u> |
| | T _____ R _____ | _____ |
| | T _____ R _____ | _____ |
| | T _____ R _____ | _____ |
| 2. Property Controlling in Section | S _____ T _____ R _____ | _____ |
| | S _____ T _____ R _____ | _____ |
| 3. Miscellaneous Property in Sec. | S _____ T _____ R _____ | _____ |
| | S _____ T _____ R _____ | _____ |

DELTA COUNTY

LIBER 7 PAGE 319

93 DEC -2 AM 9:00

Walter C. Thomson
REGISTER OF DEEDS

Register of Deeds Stamp & File Number

4. Lot No. _____, Recorded Plat _____
5. Private Claims _____
NW COR SEC 24 & 1/4 COR COMMON TO SEC'S 24/25

| A | B | C | D | E | F | G | H | I | J | K | L | M |
|----|----|----|----|----|----|----|---|---|---|---|---|---|
| 2 | 6 | 5 | 4 | 3 | 2 | 1 | | | | | | |
| 3 | | | | | | | | | | | | |
| 4 | 7 | 8 | 9 | 10 | 11 | 12 | | | | | | |
| 5 | | | | | | | | | | | | |
| 6 | 18 | 17 | 16 | 15 | 14 | 13 | | | | | | |
| 7 | | | | | | | | | | | | |
| 8 | 19 | 20 | 21 | 22 | 23 | 24 | | | | | | |
| 9 | | | | | | | | | | | | |
| 10 | 30 | 29 | 28 | 27 | 26 | 25 | | | | | | |
| 11 | | | | | | | | | | | | |
| 12 | 31 | 32 | 33 | 34 | 35 | 36 | | | | | | |

I, M.P. DAVIS, in a field survey on MAY 19, 19 93, do hereby certify that under requirements of P.A. 74, Michigan P.A. of 1970, the corner points mentioned in lines 1 and 2 above were in conformance with regulations and rules therefore as required in the current manual of survey instructions of the United States Department of the Interior, Bureau of Land Management or by a decree of a Court of Law and/or that the corner points mentioned in lines 3, 4 and 5 above were in conformance with the rules of the Michigan Board of Land Surveyors or by a Decree of a Court of Law; established, re-established, monumented, re-monumented, recovered, found as expressed below:

NOTE: Not more than 4 corners, all in the same town and range, may be recorded on this certificate.

A. Description of original monument and accessories and/or subsequent restoration:


K-7 [NW COR SEC 24] A. MERRYWEATHER - 1846 - WOOD POST - TAMERACK 3" N70°E-7 LINKS - CEDAR 5"-S5°W-15 LINKS
M.S. McNABB - 1915 - WOOD STAKE IN PLACE
CEDAR 3" N52°W 60.5' SPRUCE 2" S53°W 55'

L-9 [1/4 COR COMMON TO SEC'S 24/25] A. MERRYWEATHER-1846-WOOD POST-W.PINE 30"-WEST-35 LINKS - BIRCH 12" N70°E 34 LINKS
M.S. McNABB - 1915 - SCRIBED WOOD POST FOUND IN PLACE DROVE IRON
BT STAKE N45°E 22.1' POPPLE 6" S28°15'W 198'
REFERENCE CITY OF ESCANABA CITY ENGINEER'S RECORDS FOR ALIGNMENT FOR N. 30TH STREET.

B. Description of corner evidence found and/or method applied in restoring or reestablishing corner:

K-7 [NW COR SEC 24] FOUND 1-1/4" IRON PIPE IN PLACE-MEASUREMENT WEST TO NW COR OF SEC 23 & EAST TO N1/4 COR SEC 24 CORRESPONDS WELL WITH RECORD DISTANCES-NO EVIDENCE OF McNABB'S 1915 BT'S FOUND - ACCEPTED EXISTING MONUMENT AS A CAREFUL & FAITHFUL REESTABLISHMENT OF THE POSITION OF THE ORIGINAL CORNER

L-9 [1/4 COR COMMON TO SEC'S 24/25] FOUND IRON PIN & REMAINS OF WOOD POST SCRIBED "1/4" AS MENTIONED IN M.S. McNABB'S 1915 FIELD NOTES - ACCEPTED EXISTING MONUMENT AS A CAREFUL & FAITHFUL REESTABLISHMENT OF THE POSITION OF THE ORIGINAL CORNER

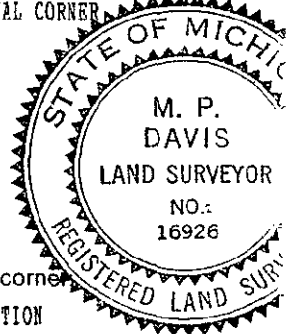

C. Description of monument for corner and accessories established to perpetuate locating the position of the corner:

K-7 SET OVER EXISTING I.P. A BERNTSEN AINB30 ALUMINUM MONUMENT W/A 3-1/4" CAP STAMPED TO ID THE CORNER POSITION
CEDAR 3" TAMARACK 9" TAMARACK 10" SURVEY MONUMENT SIGN POST
N29°W N53°E S19°E S45°W
25.80' 30.55' 18.19' 2.00' (TO FACE)

L-9 REPLACED IRON PIN WITH A 4" X 4" X 36" CONCRETE MONUMENT W/A BRASS CAP STAMPED TO ID THE COR POSITION
POWER POLE SURVEY MONUMENT SIGN POST
WEST N45°E
2.38' (TO FACE) 1.21" (TO FACE)

NOTE: BEARINGS TO REFERENCE OBJECTS ARE MAGNETIC & DISTANCE ARE TO A NAIL IN THE CENTER OF THE OBJECT UNLESS NOTED OTHERWISE

Signed by M.P. Davis Date 10/10/93

Surveyor's Michigan License No. 16926