

**SURVEY &  
REMONUMENTATION**

DEC 07 1993

COMMISSION

**LAND CORNER RECORDATION CERTIFICATE**  
Filing Requirement of Act 74, Mich. P.A. 1970

Approved By Delta County  
Land Survey Remonumentation  
Peer Group Under Act 345 Of  
P.A. Of 1990 On November 30, 1993  
*Robert Schueler*  
Acting Chairman

For corners in  
DELTA  
(County)

DELTA COUNTY

LIBER 7 PAGE 342

93 DEC -2 AM 9:00

*Walter C. Thoman*  
REGISTER OF DEEDS

Register of Deeds Stamp & File Number

	Located In:	Corner Code #
1. Public Land Survey	T <u>39 N</u> R <u>23 W</u>	<u>M-8 &amp; M-9</u>
	T _____ R _____	_____
	T _____ R _____	_____
	T _____ R _____	_____
2. Property Controlling in Section	S _____ T _____ R _____	_____
	S _____ T _____ R _____	_____
3. Miscellaneous Property in Sec.	S _____ T _____ R _____	_____
	S _____ T _____ R _____	_____

4. Lot No. \_\_\_\_\_, Recorded Plat \_\_\_\_\_  
5. Private Claims [M-8] E1/4 COR SEC 24 [M-9] NE COR SEC 25

	A	B	C	D	E	F	G	H	I	J	K	L	M
2	6	5	4	3	2	1							
3													
4	7	8	9	10	11	12							
5													
6	18	17	16	15	14	13							
7													
8	19	20	21	22	23	24							
9													
10	30	29	28	27	26	25							
11													
12	31	32	33	34	35	36							
13													

I, M.P. DAVIS, in a field survey on MAY, 19 93, do hereby certify that under requirements of P.A. 74, Michigan P.A. of 1970, the corner points mentioned in lines 1 and 2 above were in conformance with regulations and rules therefore as required in the current manual of survey instructions of the United States Department of the Interior, Bureau of Land Management or by a decree of a Court of Law and/or that the corner points mentioned in lines 3, 4 and 5 above were in conformance with the rules of the Michigan Board of Land Surveyors or by a Decree of a Court of Law; established, re-established, monumented, re-monumented, recovered, found as expressed below:


**NOTE: Not more than 4 corners, all in the same town and range, may be recorded on this certificate.**

- A. Description of original monument and accessories and/or subsequent restoration:  
 M-8 [E1/4 COR SEC 24] WOOD POST - JOHN BURT 1845 - (W.PINE 34°-N71°E-15 LINKS) (HEMLOCK 6°-S82°W-30 LINKS)  
 M.S. McNABB - 1915 - FOUND IRON STAKE IN PLACE - (NORWAY 15°-N46°E-65.4') (W.PINE 16°-S53°W-53.0')  
 M-9 [NE COR SEC 25] WOOD POST - JOHN BURT 1845 (W.BIRCH 6°-N58°E-28 LINKS) (W.BIRCH 5°-S64°W-46 LINKS)  
 M.S. McNABB - 1915 - IRON STAKE IN PLACE - 6.2' WEST OF WEST RAIL OF RR (W.PINE 4°-S86°W-50.35') (W.PINE 5°-S16°30'W-59.95')

- B. Description of corner evidence found and/or method applied in restoring or reestablishing corner:  
 M-8 [E1/4 COR SEC 24] FOUND IRON BOLT IN CONCRETE ROAD BED-IDENTIFIED FROM McNABB'S NORWAY BT (STILL GREEN) & THE PLAT OF I. STEPHENSON COMPANY'S 1ST ADDITION TO ESCANABA, LIBER "A" OF PLATS ON PAGE 34. THIS CORNER MONUMENT IS ACCEPTED AS A CAREFUL & FAITHFUL REESTABLISHMENT OF THE POSITION OF THE ORIGINAL CORNER  
 M-9 [NE COR SEC 25] FOUND 8" CONCRETE MONUMENT W/A 3/4" BRASS PIN CENTER IN PLACE - IDENTIFIED COR MONUMENT FROM McNABB'S REFERENCE WEST RAIL OF RR & INFORMATION FROM THE ESCANABA CITY ENGINEERS RECORDS. THIS CORNER MONUMENT IS ACCEPTED AS A CAREFUL & FAITHFUL REESTABLISHMENT OF THE POSITION OF THE ORIGINAL CORNER.

C. Description of monument for corner and accessories established to perpetuate locating the position of the corner:

M-8 DID NOT DISTURB EXISTING MONUMENT			
CHISELED CROSS ON WEST END CURB RETURN	NORWAY PINE 24"	POWER POLE	
N37°W	N46°E	S50°W	
39.30'	66.50'	37.00'	
M-9 DID NOT DISTURB EXISTING MONUMENT			
W.PINE 18"	W. PINE 17"	POWER POLE	SW COR CONC BLK BLDG
N52°W	S20W	S52°E	N20°E
61.20'	60.50'	51/50'	37.80'

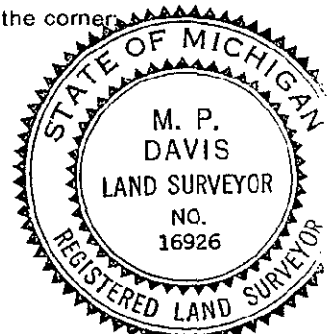

NOTE: BEARINGS TO REFERENCE OBJECTS ARE MAGNETIC & DISTANCE ARE TO A NAIL IN THE CENTER OF THE OBJECT UNLESS NOTED OTHERWISE

Signed by M.P. Davis Date 11/15/93  
 Surveyor's Michigan License No. 16926