

# SURVEY & REMONUMENTATION

SEP 13 1994

COMMISSION

Approved By Delta County  
Land Survey Remonumentation  
Peer Group Under Act 345 Of

P.A. OF 1990 On May 19, 1994

*Robert K. ...*  
Acting Chairman

## LAND CORNER RECORDATION CERTIFICATE

Filing Requirement of Act 74, Mich. P.A. 1970

For corners in  
DELTA  
(County)

Located In: Corner Code =#

1. Public Land Survey	T	39 N	R	24 W	A-9 & A-10
	T		R		
	T		R		
	T		R		
2. Property Controlling in Section	S		T	R	
	S		T	R	
3. Miscellaneous Property in Sec.	S		T	R	
	S		T	R	

JUN -8 1994

Recorded at 9:00 o'clock AM in Liber 8 Page 1  
*William C. Thorne* Reg. of Deeds.  
Delta County, Michigan  
Register of Deeds Stamp & File Number

4. Lot No. \_\_\_\_\_, Recorded Plat \_\_\_\_\_  
5. Private Claims A-9 [NW COR S.30] A-10 [W1/4 COR S.30]


	A	B	C	D	E	F	G	H	I	J	K	L	N
2	6	5	4	3	2	1							
3													
4	7	8	9	10	11	12							
5													
6	18	17	16	15	14	13							
7													
8	19	20	21	22	23	24							
9													
10	30	29	28	27	26	25							
11													
12	31	32	33	34	35	36							
13													

I, M.P. DAVIS, in a field survey on MAY, 19 94, do hereby certify that under requirements of P.A. 74, Michigan P.A. of 1970, the corner points mentioned in lines 1 and 2 above were in conformance with regulations and rules therefore as required in the current manual of survey instructions of the United States Department of the Interior, Bureau of Land Management or by a decree of a Court of Law and/or that the corner points mentioned in lines 3, 4 and 5 above were in conformance with the rules of the Michigan Board of Land Surveyors or by a Decree of a Court of Law; established, re-established, monumented, re-monumented, recovered, found as expressed below:

NOTE: Not more than 4 corners, all in the same town and range, may be recorded on this certificate.

- A. Description of original monument and accessories and/or subsequent restoration:  
 A-9 [NW COR S.30] JAMES H. MULLETTE, D.S. - 1848 - WOOD POST (BEECH 12"-N36°W-25 LINKS) (HEMLOCK 14"-S29°W-18 LINKS) GEORGE ADAIR, D.S. - 1852 - WOOD POST (HEMLOCK 12"-N38°E-12 LINKS) (HEMLOCK 14"-S24°E-25 LINKS) M.S. McNABB - 1918 - IDENTIFIED CORNER BY STUMP OF ORIGINAL BT (WHICH ONE NOT INDICATED) RESET STAKE & BT STAKES NE & SW 33'  
 A-10 [W1/4 COR S.30] JAMES H. MULLETTE, D.S. - 1848 - WOOD POST (BEECH 06"-S62°W-12 LINKS) (SUGAR 30"-N33°W-27 LINKS) NO RECORD EVIDENCE OF SUBSEQUENT CORNER RECOVERY OR MONUMENTATION

- B. Description of corner evidence found and/or method applied in restoring or reestablishing corner:  
 A-9 [NW COR S.30] FOUND IN PLACE A 3/4" IRON PIN AT THE APPROX C/L PI OF COUNTY ROADS N & E IDENTIFIED EXISTING MONUMENT AS BEING A PERPETUATION OF THE WOOD STAKE SET BY M.S. McNABB IN 1918 BY RETRACEMENT OF McNABB'S SURVEY OF THE SOUTH LINE OF SEC 19. ACCEPTED EXISTING MONUMENT AS BEING A CAREFUL & FAITHFUL PERPETUATION OF THE POSITION OF THE ORIGINAL CORNER.  
 A-10 [W1/4 COR S.30] NO EVIDENCE OF AN EXISTING CORNER MONUMENT FOUND. AS SECTION 30 IS ALL ENCOMPASSED BY FARM LAND IT APPEARS THAT THE CORNER POSITIONS ARE NOW OCCUPIED BY CORNER FENCE POST. A CHECK OF THE WEST LINE OF SEC 30 SHOWS THAT THE CORNER FENCE POST FOUND AT THE N & S 1/16 COR'S FIT THE EQUAL SPLIT FOR THE 1/2 MILES. AS NOT TO DISRUPT LONG STANDING OCCUPATION I HAVE ACCEPTED THAT POSITION FOR THE 1/4 COR AS DICTATED BY THE EXISTING LINES OF OCCUPATION AS BEING THE BEST AVAILABLE EVIDENCE AS TO THE POSITION OF THE ORIGINAL CORNER.

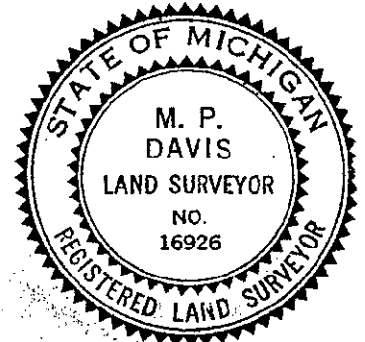

- C. Description of monument for corner and accessories established to perpetuate locating the position of the corner:  
 A-9 SET OVER THE EXISTING MONUMENT A BERNTSEN A1NB30 ALUMN MON WITH THE CAP STAMPED TO ID THE CORNER POSITION.  
 SPRUCE 11' POWER POLE SPRUCE 9' SURVEY MONUMENT SIGN POST  
 N63°W S34°E S67°E WEST  
 71.27' 41.60' (TO FACE) 73.82' 1.43' (TO FACE)  
 A-10 SET BERNTSEN A1NB30 ALUMN MON WITH THE CAP STAMPED TO ID THE CORNER POSITION.  
 NORWAY PINE 16' SURVEY MONUMENT SIGN POST NOTE: OPEN FARM FIELDS SURROUND THE CORNER POSITION  
 S15°E S56°W NO OTHER WIT'S AVAILABLE COR MONUMENT IS IN THE  
 29.66' 7.77' (TO FACE) SOUTHWHEED RUT OF AN E-W FARM ROAD

NOTE: BEARINGS TO REFERENCE OBJECTS ARE MAGNETIC & DISTANCES ARE TO A NAIL IN THE CENTER OF THE OBJECT, UNLESS OTHERWISE NOTED.

Signed by M.P. Davis Date 5/14/94

Surveyor's Michigan License No. 16926