

SURVEY & REMONUMENTATION COMMISSION

SEP 13 1994

COMMISSION

LAND CORNER RECORDATION CERTIFICATE
Filing Requirement of Act 74, Mich. P.A. 1970

Approved by Delta County
Land Survey Remonumentation
Peer Group Under Act 345 Of
P.A. Of 1990 On June 8, 1994
Robert Schumling
Chairman

For corners in
DELTA
(County)

Located In: Corner Code --#

1. Public Land Survey	T 39 N R 24 W	C-5 & C-6
	T R	
	T R	
	T R	
2. Property Controlling in Section	S T R	
	S T R	
3. Miscellaneous Property in Sec.	S T R	
	S T R	

JUN -9 1994

Recorded
at 9:00 o'clock AM in Liber 8 Page 10
William C. Thomas Reg. of Deeds.
Delta County, Michigan
Register of Deeds Stamp & File Number

4. Lot No. _____, Recorded Plat _____
5. Private Claims C-5 [NW COR S.17] C-6 [W1/4 COR S.17]

I, M.P. DAVIS, in a field survey on MAY, 19 94, do hereby certify that under requirements of P.A. 74, Michigan P.A. of 1970, the corner points mentioned in lines 1 and 2 above were in conformance with regulations and rules therefore as required in the current manual of survey instructions of the United States Department of the Interior, Bureau of Land Management or by a decree of a Court of Law and/or that the corner points mentioned in lines 3, 4 and 5 above were in conformance with the rules of the Michigan Board of Land Surveyors or by a Decree of a Court of Law; established, re-established, monumented, re-monumented, recovered, found as expressed below:

A	B	C	D	E	F	G	H	I	J	K	L	M
2	6	5	4	3	2	1						
3												
4	7	8	9	10	11	12						
5												
6	18	17	16	15	14	13						
7												
8	19	20	21	22	23	24						
9												
10	30	29	28	27	26	25						
11												
12	31	32	33	34	35	36						
13												

NOTE: Not more than 4 corners, all in the same town and range, may be recorded on this certificate.


A. Description of original monument and accessories and/or subsequent restoration:
C-5 [NW COR S.17] GEORGE ADAIR, D.S. - 1852 - WOOD POST (SUGAR 10°-N40°W-40 LINKS) (SUGAR 12°-S27°W-24 LINKS)
M.S. McNABB-1914-IDENTIFIED BY IRON STAKE & BT'S IN PLACE FROM PREVIOUS SURVEY (COR FENCE POSTS N48°W-24.5' & N45°E-24.5')
M.S. McNABB - 1927 - IDENTIFIED BY IRON STAKE IN PLACE FROM PREVIOUS SURVEYS (NO WIT'S NOTED)

C-6 [W1/4 COR S.17] GEORGE ADAIR, D.S. - 1852 - WOOD POST (ELM 20°-N54°E-22 LINKS) (SUGAR 15°-S.69°W-27 LINKS)
D.A. BROTHERTON-1911-COR IN PLACE, NO OTHER DESCRIPTION GIVEN (WIRE FENCE NORTH-33.5') (COR FENCE POST-SWLY-33.7')
M.S. McNABB-1914-IRON STAKE SET PREVIOUS (BT STAKE-SW-33') (FENCE POST-N38°E-22')

B. Description of corner evidence found and/or method applied in restoring or reestablishing corner:

C-5 [NW COR S.17] FOUND IRON BOLT IN MONUMENT BOX. IRON BOLT WAS RECOVERED BY MYSELF IN 1972 AND REC'D IN LCR'S LIBER 1, PAGE 32. THE IRON BOLT AS FOUND IS AT THE APPROX JCT OF COUNTY ROAD C/L'S N-S & E-W. DISTANCES E-W & N TO ADJOINING CORNERS CHECK WELL WITH RECORD. ACCEPTED AS BEING THE BEST AVAILABLE EVIDENCE AS TO THE LOCATION OF THE POSITION OF THE ORIGINAL CORNER.

C-6 [W1/4 COR S.17] FOUND IRON PIN IN PLACE AS INDICATED BY ANCIENT LINES OF OCCUPATION & N-S COUNTY ROAD IMPROVEMENTS. BELIEVE THIS MONUMENT TO BE THE ONE FOUND IN PLACE IN 1914 BY M.S. McNABB. ACCEPTED EXISTING MONUMENT AS BEING THE BEST AVAILABLE EVIDENCE AS TO THE LOCATION OF THE POSITION OF THE ORIGINAL CORNER.

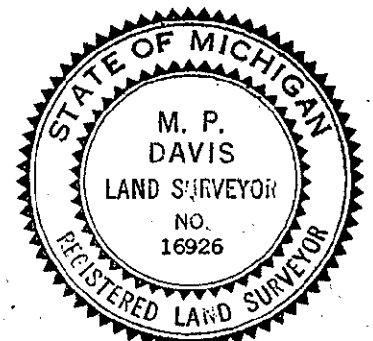

C. Description of monument for corner and accessories established to perpetuate locating the position of the corner:

C-5 SET OVER EXISTING MONUMENT A 5/8" X 18" REBAR W/A 3-1/4' ALUMN CAP STAMPED TO ID THE CORNER POSITION.
POWER POLE POWER POLE GALV ROAD SIGN POST SURVEY MONUMENT SIGN POST
N51°W N53°E S41°E S53°W
54.23' (TO FACE) 43.13' (TO FACE) 59.53' (TO FACE) 48.21' (TO FACE)

C-6 SET OVER EXISTING MON A 5/8" X 18" REBAR W/A 3-1/4' ALUMN CAP STAMPED TO ID THE COR POSITION & RAISED TO RD SURFACE W/A MON BOX
POWER POLE MAPLE 28' SURVEY MONUMENT SIGN POST
N67°E S43°W WEST
39.22' (TO FACE) 76.23' 11.79' (TO FACE)

NOTE: BEARINGS TO REFERENCE OBJECTS ARE MAGNETIC & DISTANCES ARE TO A NAIL IN THE CENTER OF THE OBJECT, UNLESS OTHERWISE NOTED.

Signed by M.P. Davis

Date 6/7/94

Surveyor's Michigan License No. 16926