


SURVEY & REMONUMENTATION

DEC 07 1993

COMMISSION

LAND CORNER RECORDATION CERTIFICATE Filing Requirement of Act 74, Mich. P.A. 1970

Approved By Delta County
Land Survey Remonumentation
Peer Group Under Act 345 Of
P.A. Of 1990 On Sept 23, 1993
Robert Schmelting
Chairman

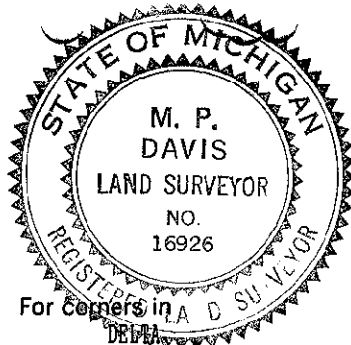

| | | |
|--|---|--|
| 1. Public Land Survey 2. Property Controlling in Section 3. Miscellaneous Property in Sec. | Located In: T 39 N R 24 W T _____ R _____ T _____ R _____ T _____ R _____ S _____ T _____ R _____ S _____ T _____ R _____ S _____ T _____ R _____ S _____ T _____ R _____ | Corner Code #: C-10 & C-11 _____ _____ _____ _____ _____ _____ _____ |
|--|---|--|

L. 7 Pg 308

Register of Deeds Stamp & File Number

4. Lot No. _____, Recorded Plat _____

5. Private Claims _____
 1/4 CORNER COMMON TO SEC'S 30/29 & SW CORNER SEC 29

| | A | B | C | D | E | F | G | H | I | J | K | L | M |
|----|----|----|----|----|----|----|---|---|---|---|---|---|---|
| 2 | 6 | 5 | 4 | 3 | 2 | 1 | | | | | | | |
| 3 | | | | | | | | | | | | | |
| 4 | 7 | 8 | 9 | 10 | 11 | 12 | | | | | | | |
| 5 | | | | | | | | | | | | | |
| 6 | 18 | 17 | 16 | 15 | 14 | 13 | | | | | | | |
| 7 | | | | | | | | | | | | | |
| 8 | 19 | 20 | 21 | 22 | 23 | 24 | | | | | | | |
| 9 | | | | | | | | | | | | | |
| 10 | 30 | 29 | 28 | 27 | 26 | 25 | | | | | | | |
| 11 | | | | | | | | | | | | | |
| 12 | 31 | 32 | 33 | 34 | 35 | 36 | | | | | | | |
| 13 | | | | | | | | | | | | | |

I, M. P. DAVIS, in a field survey on AUGUST, 19 93, do hereby certify that under requirements of P.A. 74, Michigan P.A. of 1970, the corner points mentioned in lines 1 and 2 above were in conformance with regulations and rules therefore as required in the current manual of survey instructions of the United States Department of the Interior, Bureau of Land Management or by a decree of a Court of Law and/or that the corner points mentioned in lines 3, 4 and 5 above were in conformance with the rules of the Michigan Board of Land Surveyors or by a Decree of a Court of Law; established, re-established, monumented, re-monumented, recovered, found as expressed below:

NOTE: Not more than 4 corners, all in the same town and range, may be recorded on this certificate.

A. Description of original monument and accessories and/or subsequent restoration:

C-10 [1/4 COR COMMON TO SEC'S 30/29] WOOD POST-GEORGE ADAIR-1852 (IRONWOOD 6" CORNER TREE) (SUGAR 13"-S50°W-3 LINKS)
 D.A. BROTHERTON-1902-FOUND WOOD STAKE IN PLACE DURING SUBDIVISION OF SEC 30 (NO WIT'S NOTED)
 M.S. McNABB-1914-FOUND WOOD POST & OLD BT IN PLACE (FENCE POST S42°E-28') (CEDAR STAKE-NW-33')

C-11 [SW COR OF SEC 29] WOOD POST-GEORGE ADAIR-1852 (LYNN 12"-N27°W-50 LINKS) (YELLOW BIRCH 14"-S46°E-14 LINKS)
 D.A. BROTHERTON-1902-FOUND WOOD STAKE IN PLACE DURING SUBDIVISION OF SEC 30 (MAPLE N34°E 22.1')

B. Description of corner evidence found and/or method applied in restoring or reestablishing corner:

C-10 [1/4 CORNER COMMON TO SEC'S 30/29] RETRACED BROTHERTON'S 1902 E-W 1/4 LINE OF SEC 30 WEST FROM THE W1/4 COR (NOW OCCUPIED BY CORNER FENCE POST) USED EXISTING FARM FENCES FOR N-S & E-W CONTROL AS DISTANCES BETWEEN FENCES MATCH WELL WITH BROTHERTON'S SURVEY RECORDS, ESTABLISHED 1/4 CORNER FROM THESE IMPROVEMENTS, THIS POSITION IS ACCEPTED AS THE BEST AVAILABLE EVIDENCE OF THE POSITION OF THE ORIGINAL CORNER.

C-11 [SW CORNER SEC 29] EXTENDED SURVEY LINE EAST FROM S1/4 COR SEC 30 (NOW OCCUPIED BY JCT OF FARM FENCE LINES E-W & N) THRU JCT OF E-W & N FENCE LINES AT THE E1/16 AND SET THE SEC CORNER ON THIS LINE AT PROPORTIONATE DISTANCE EAST OF 1/16 CORNER FENCE POST. THIS POSITION IS ACCEPTED AS THE BEST AVAILABLE EVIDENCE OF THE ORIGINAL CORNER POSITION.

C. Description of monument for corner and accessories established to perpetuate locating the position of the corner:

C-10 SET, INSIDE OF A MONUMENT BOX, A 5/8" X 18" REBAR W/A 3-1/4" ALUMINUM CAP STAMPED TO IDENTIFY THE CORNER POSITION .

| | | | |
|-------------|------------|-----------------------------|--------------------|
| ANCHOR POLE | POWER POLE | 2-1/2" GALV. ROAD SIGN POST | ALUMINUM SIGN POST |
| S43°E | S38°W | N39°W | EAST |
| 50.70' | 42.92' | 37.10' (TO CENTER) | 37.57' (TO FACE) |

C-11 SET, INSIDE OF A MONUMENT BOX, A 5/8" X 18" REBAR W/A 3-1/4" ALUMINUM CAP STAMPED TO IDENTIFY THE CORNER POSITION.

| | | |
|-------------|--------|----------------------|
| BASSWOOD 5" | ASH 6" | C.L. N-S COUNTY ROAD |
| S21°E | N84°W | EAST |
| 106.60' | 36.20' | 5.5' |

NOTE: BEARINGS TO REFERENCE OBJECTS ARE MAGNETIC - DISTANCES ARE TO A NAIL IN THE CENTER OF THE OBJECT UNLESS NOTED OTHERWISE

Signed by M. P. Davis Date 9/22/93

Surveyor's Michigan License No. 16926