

**SURVEY & REMONUMENTATION**

DEC 07 1993

COMMISSION

**LAND CORNER RECORDATION CERTIFICATE**  
Filing Requirement of Act 74, Mich. P.A. 1970

Approved by Delta County  
Land Survey Remonumentation  
Peer Group Under Act 345 Of  
P.A. Of 1990 On Sept 23, 1993  
*Robert E. LaBonte*  
Acting Chairman

For corners in  
DELTA  
(County)


Located In: Corner Code #/

1. Public Land Survey	T <u>39 N</u> R <u>R4 W</u>	<u>C-12 &amp; C-13</u>
	T _____ R _____	_____
	T _____ R _____	_____
	T _____ R _____	_____
2. Property Controlling in Section	S _____ T _____ R _____	_____
	S _____ T _____ R _____	_____
3. Miscellaneous Property in Sec.	S _____ T _____ R _____	_____
	S _____ T _____ R _____	_____

Liber 7 Pg. 309

Register of Deeds Stamp & File Number

4. Lot No. \_\_\_\_\_, Recorded Plat \_\_\_\_\_  
5. Private Claims  
1/4 COR COMMON TO SEC'S 31/32 & SW COR OF SEC 32

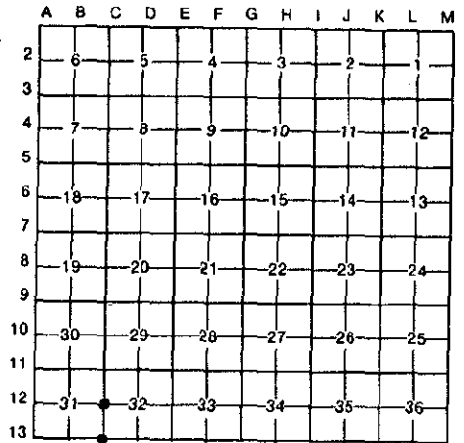

I, M.P. DAVIS, in a field survey on AUGUST, 1993, do hereby certify that under requirements of P.A. 74, Michigan P.A. of 1970, the corner points mentioned in lines 1 and 2 above were in conformance with regulations and rules therefore as required in the current manual of survey instructions of the United States Department of the Interior, Bureau of Land Management or by a decree of a Court of Law and/or that the corner points mentioned in lines 3, 4 and 5 above were in conformance with the rules of the Michigan Board of Land Surveyors or by a Decree of a Court of Law; established, re-established, monumented, re-monumented, recovered, found as expressed below:

**NOTE: Not more than 4 corners, all in the same town and range, may be recorded on this certificate.**

- A. Description of original monument and accessories and/or subsequent restoration:  
C-12 [1/4 COR COMMON TO SEC'S 31/32] WOOD POST-GEORGE ADAIR-1852 (SUGAR 16° N45°W-25 LINKS) (SUGAR 7°-S44°E-31 LINKS)  
NO RECORD EVIDENCE OF SUBSEQUENT RESTORATION OF THIS CORNER POSITION  
C-13 [SW COR SEC 32] WOOD POST-JAMES MULLET-1848 (BEECH 8°-N76°E-46 LINKS) (BEECH 10°-N38°W-41 LINKS)  
WOOD POST-GEORGE ADAIR-1852 (SUGAR 14°-S50°W-15 LINKS) (BEECH 6°-S45°E-11 LINKS)  
NO RECORD EVIDENCE OF SUBSEQUENT RESTORATION OF THIS CORNER POSITION

- B. Description of corner evidence found and/or method applied in restoring or reestablishing corner:  
C-12 [1/4 COR COMMON TO SEC'S 31/32] FOUND 1/2" X 15" IRON PIN AT JCT OF COUNTY ROADS N-S & E-W, ORIGIN UNKNOWN, THIS POSITION APPEARS AS A BEST FIT OF EXISTING OCCUPATION AND IS ACCEPTED AS A CAREFUL AND FAITHFUL REESTABLISHMENT OF THE POSITION OF THE ORIGINAL CORNER.  
C-13 [SW COR SEC 32] FOUND 1/2" X 15" IRON PIN AT JCT OF COUNTY ROADS N-S & E-W, ORIGIN UNKNOWN, THIS POSITION APPEARS TO BEST FIT EXISTING OCCUPATION AND IS ACCEPTED AS A CAREFUL AND FAITHFUL REESTABLISHMENT OF THE POSITION OF THE ORIGINAL CORNER.



- C. Description of monument for corner and accessories established to perpetuate locating the position of the corner:  
C-12 REPLACED EXISTING MONUMENT W/A 5/8" X 18" REBAR W/A 3-1/4" ALUMINUM CAP STAMPED TO IDENTIFY THE CORNER POSITION  
MONUMENT BOX  
SPRUCE 12" (SHADE TREE) POWER POLE STOP SIGN ALUMINUM SIGN POST  
N57°E S50°E S64°W N45°W  
46.55' 42.50' 37.35' (TO FACE) 47.10' (TO FACE)  
C-13 REPLACED EXISTING MONUMENT W/A 5/8" X 18" REBAR W/A 3-1/4" ALUMINUM CAP STAMPED TO IDENTIFY THE CORNER POSITION & PLACED INSIDE A MONUMENT BOX.  
SPRUCE 6"- SPRUCE 9" MAPLE 20" SE CORNER OF HOUSE  
N46°E-57.85' S29°E-85.80' S51°W-67.05' N54°W-95.70'

NOTE: BEARINGS TO REFERENCE OBJECTS ARE MAGNETIC - DISTANCES ARE TO A NAIL IN THE CENTER OF THE OBJECT UNLESS NOTED OTHERWISE

Signed by M.P. Davis Date 9/22/93  
Surveyor's Michigan License No. 16926