

SEP 13 1994

COMMISSION

Approved By Delta County Land Survey Remonumentation Peer Group Under Act 345 Of P.A. Of 1990 On June 8, 1994
John P. Stelmach
Chairman

LAND CORNER RECORDATION CERTIFICATE
Filing Requirement of Act 74, Mich. P.A. 1970

For corners in
DELTA
(County)

| Located In: | Corner Code # |
|-------------------------|---------------|
| T 39 N R 24 W | F-9 & F-11 |
| T _____ R _____ | _____ |
| T _____ R _____ | _____ |
| T _____ R _____ | _____ |
| S _____ T _____ R _____ | _____ |
| S _____ T _____ R _____ | _____ |
| S _____ T _____ R _____ | _____ |
| S _____ T _____ R _____ | _____ |

Recorded JUN -9 1994
at 9:00 o'clock AM in Liber 8 Page 13
John C. Thomas Reg. of Deeds.
Delta County, Michigan
Register of Deeds Stamp & File Number

- Public Land Survey
- Property Controlling in Section
- Miscellaneous Property in Sec.
- Lot No. _____, Recorded Plat _____
- Private Claims
F-9 [N1/4 COR S.28] F-11 [N1/4 COR S.33]


| | A | B | C | D | E | F | G | H | I | J | K | L | M |
|----|----|----|----|----|----|----|---|---|---|---|---|---|---|
| 2 | 6 | 5 | 4 | 3 | 2 | 1 | | | | | | | |
| 3 | | | | | | | | | | | | | |
| 4 | 7 | 8 | 9 | 10 | 11 | 12 | | | | | | | |
| 5 | | | | | | | | | | | | | |
| 6 | 18 | 17 | 16 | 15 | 14 | 13 | | | | | | | |
| 7 | | | | | | | | | | | | | |
| 8 | 19 | 20 | 21 | 22 | 23 | 24 | | | | | | | |
| 9 | | | | | | | | | | | | | |
| 10 | 30 | 29 | 28 | 27 | 26 | 25 | | | | | | | |
| 11 | | | | | | | | | | | | | |
| 12 | 31 | 32 | 33 | 34 | 35 | 36 | | | | | | | |
| 13 | | | | | | | | | | | | | |

I, M.P. DAVIS, in a field survey on _____, 19 94, do hereby certify that under requirements of P.A. 74, Michigan P.A. of 1970, the corner points mentioned in lines 1 and 2 above were in conformance with regulations and rules therefore as required in the current manual of survey instructions of the United States Department of the Interior, Bureau of Land Management or by a decree of a Court of Law and/or that the corner points mentioned in lines 3, 4 and 5 above were in conformance with the rules of the Michigan Board of Land Surveyors or by a Decree of a Court of Law; established, re-established, monumented, re-monumented, recovered, found as expressed below:

NOTE: Not more than 4 corners, all in the same town and range, may be recorded on this certificate.

- A. Description of original monument and accessories and/or subsequent restoration:
- F-9 [N1/4 COR S.28] GEORGE ADAIR, D.S. - 1852 - SUGAR 24"-CORNER TREE (SUGAR 10"-SOUTH 14 LINKS)
D.A. BROTHERTON-1909-ORIGINAL DESTROYED BY ROAD COMMISSION - SET 1/2 DISTANCE BETWEEN CORNERS - NO NEW WIT'S NOTED OR DESCRIPTION OF MONUMENT SET GIVEN
M.S. McNABB-1916-IDENTIFIED FROM PROPERTY LINES & CEMETERY FENCE-RESET STAKE (BT STAKES NW & SE 25')
 - F-11 [N1/4 COR S.33] GEORGE ADAIR, D.S. - 1852 - WOOD POST (SUGAR 12"-S21°W-12 LINKS) (SUGAR 24"-N24°E-23 LINKS)
D.A. BROTHERTON-1909-RESET IRON PIN FROM TESTIMONY OF OLD SETTLER (SET BT POST NW & SE 25.5')
D.A. BROTHERTON-1910-IN PLACE FROM PREVIOUS SURVEY - NO NEW WIT'S NOTED

- B. Description of corner evidence found and/or method applied in restoring or reestablishing corner:
- F-9 [N1/4 COR S.28] FOUND 1/2" REBAR AS ESTABLISHED BY NYSELF IN 1972 & RECORDED IN LIBER 1 OF LCR'S ON PAGE 52. I ESTABLISHED THIS COR FROM INFORMATION CONTAINED IN THE PRIVATE RECORDS OF M.S. McNABB WITH REFERENCE TO THE BOUNDARIES OF THE BARK RIVER TWP CEMETERY. ACCEPTED THIS POSITION AS BEING A CAREFUL & FAITHFUL REESTABLISHMENT OF THE POSITION OF THE ORIGINAL CORNER. ALL ACCESSORIES ESTABLISHED IN 1972 HAVE BEEN REMOVED.
 - F-11 [N1/4 COR S.33] FOUND IN PLACE, AS INDICATED BY COUNTY ROAD IMPROVEMENTS & OCCUPATION, A 1" SOLID IRON PIN. NO EVIDENCE OF BROTHERTON'S BT STAKES FOUND, MEASUREMENT EAST CHECKS WELL WITH THE RECORD. ACCEPTED EXISTING MONUMENT AS BEING THE ONE SET IN 1909 BY BROTHERTON & AS BEING A CAREFUL & FAITHFUL PERPETUATION OF THE POSITION OF THE ORIGINAL CORNER.

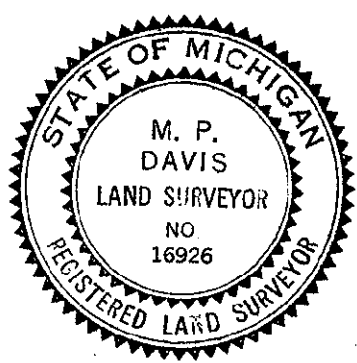

- C. Description of monument for corner and accessories established to perpetuate locating the position of the corner:
- F-9 SET, 6" BELOW COUNTY ROAD SURFACE, A 5/8" X 18" REBAR W/A 3-1/4" ALUMN CAP STAMPED TO ID THE CORNER POSITION.
RED PINE 13" POWER POLE RR X-ING SIGN SURVEY MONUMENT SIGN POST
N53°W S78°E S42°W WEST
44.19' 29.20' (TO FACE) 36.45' (TO FACE) 27.00' (TO FACE)
 - F-11 SET, OVER EXISTING MONUMENT & 6" BELOW ROAD SURFACE, A 5/8" X 18" REBAR W/A 3-1/4" ALUMN CAP STAMPED TO ID THE COR POSITION.
SURVEY MONUMENT SIGN POST POWER POLE NW COR HOUSE 2" GALV ROAD SIGN POST
SOUTH S32°E S45°E N56°E
18.13' (TO FACE) 29.81' (TO FACE) 118.82' 35.72' (TO FACE)

NOTE: BEARINGS TO REFERENCE OBJECTS ARE MAGNETIC & DISTANCES ARE TO A NAIL W/A REFERENCE TAG IN THE OBJECT, UNLESS OTHERWISE NOTED.

Signed by M.P. Davis Date 6/7/94
Surveyor's Michigan License No. 16926