

SEP 13 1994

COMMISSION

Approved by Delta County Land Survey Remonumentation Peer Group Under Act 345 Of P.A. Of 1990 On June 8, 1994

Chairman

LAND CORNER RECORDATION CERTIFICATE Filing Requirement of Act 74, Mich. P.A. 1970

For corners in DELTA (County)

Table with 3 columns: Located In, Corner Code, and 4 rows of survey types (Public Land Survey, Property Controlling, Miscellaneous, Lot No., Private Claims).

Recorded JUN - 9 1994 at 9:00 a'clock AM in Liber 8 Page 20 Register of Deeds Stamp & File Number

1. Public Land Survey T 39 N R 24 W I-7 I-8
2. Property Controlling in Section S T R
3. Miscellaneous Property in Sec. S T R


Grid table with columns A-M and rows 2-13, containing numbers 6-36.

I, M.P. DAVIS, in a field survey on MAY, 19 94, do hereby certify that under requirements of P.A. 74, Michigan P.A. of 1970, the corner points mentioned in lines 1 and 2 above were in conformance with regulations and rules therefore as required in the current manual of survey instructions of the United States Department of the Interior, Bureau of Land Management or by a decree of a Court of Law and/or that the corner points mentioned in lines 3, 4 and 5 above were in conformance with the rules of the Michigan Board of Land Surveyors or by a Decree of a Court of Law; established, re-established, monumented, re-monumented, recovered, found as expressed below:

NOTE: Not more than 4 corners, all in the same town and range, may be recorded on this certificate.

- A. Description of original monument and accessories and/or subsequent restoration: I-7 [NW COR S.23] GEORGE ADAIR, D.S. - 1852 - WOOD POST (W.PINE 18"-N62"E-44 LINKS) (TAMARACK 11"-S72"W-18 LINKS) D.A.BROTHERTON - 1896 - IDENTIFIED CORNER POSITION FROM ORIGINALS & NOTED NEW BT (HEMLOCK 10"-N74"30'E-54.7') M.S.McNABB - 1913 - STAKE IN HWY - FENCE POST N27"E-23' I-8 [W1/4 COR S.23] GEORGE ADAIR, D.S. - 1852 - WOOD POST (HEMLOCK 14"-N68"E-17 LINKS) (HEMLOCK 12"-S57"W-61 LINKS) D.A.BROTHERTON - 1896 - IDENTIFIED FROM ORIGINALS - NO NEW WIT'S NOTED M.S.McNABB - 1913 - IDENTIFIED FROM RECORDS & NOTED NEW BT (ELM-4"-N10"E-7') M.S.McNABB - 1919 - IDENTIFIED FROM PREVIOUS SURVEY -PINE STUMP-N75"W-28.0' M.S.McNABB - 1946 - IDENTIFIED FROM PREVIOUS SURVEYS - ELM 12"-S22"W-92.6' & W. BIRCH 10"-N38"E-49.0'

- B. Description of corner evidence found and/or method applied in restoring or reestablishing corner: I-7 [NW COR S.23] COMPASS & CHAIN WEST FROM THE N1/4 COR SEC 23 TO THE APPROX CORNER POSITION AND POSITIONED A TEMPORARY COR FROM THE GLO TERRAIN CALLS TO THE SWP EDGE 1 CHAIN NORTH AND 2 CHAINS EAST. FROM THIS POINT A SEARCH FOR THE GLO BT'S WAS MADE, AT THE APPROX GLO DISTANCE AND BEARING FROM THE TEMPORARY COR A LARGE PINE STUMP WAS RECOVERED. THE STUMP IS IN SUCH A STATE OF DECAY AS NOT TO PERMIT THE IDENTIFICATION OF ANY IRON MARKS OR THE MEASURING NOTCH. BECAUSE OF THE CORRELATION OF THE TERRAIN CALLS & THE PINE STUMP I HAVE ACCEPTED THE PINE STUMP AS BEING THAT OF THE GLO & HAVE RESET THE COR S62"W-44 LINKS FROM THE PINE STUMP AS PER RECORD. I-8 [W1/4 COR S.23] FOUND IN PLACE A 1" IRON PIPE. IDENTIFIED COR POSITION BY GLO CALLS SOUTH TO THE 10 MILE CREEK & THE REMAINS OF AN OLD FARM FENCE N & S. FROM THE I.P. THE REMAINS OF AN ELM STUMP BEARS S22"W-92.6' & A PINE STUMP (MEASURING NOTCH PLAIN) BEARS N75"W-28'. ACCEPTED EXISTING MONUMENT AS BEING A CAREFUL & FAITHFUL PERPETUATION OF THE POSITION OF THE ORIGINAL CORNER.

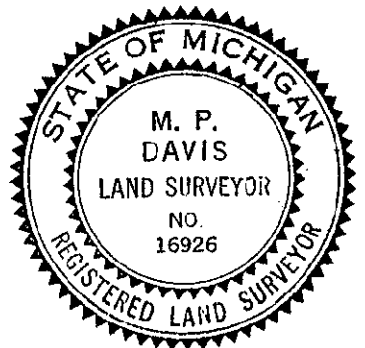

- C. Description of monument for corner and accessories established to perpetuate locating the position of the corner: I-7 SET A BERNTSEN A1NB30 ALUMN MONUMENT WITH THE CAP STAMPED TO ID THE CORNER POSITION. BALSAM 8" SPRUCE 10" SPRUCE 9" SPRUCE 7" SURVEY MONUMENT SIGN POST N7"W 30.33' N61"E 25.80' S12"E 36.29' S86"W 22.54' S45"E 2.25' (TO FACE) I-8 SET OVER EXISTING MONUMENT A BERNTSEN A1NB30 ALUMN MONUMENT WITH THE CAP STAMPED TO ID THE CORNER POSITION. W.BIRCH 13" W.BIRCH 14" SPRUCE 9" SURVEY MONUMENT SIGN POST N46"W 33.60' S35"W 31.00' S80"W 76.40' SOUTH 2.20' (TO FACE)

NOTE: BEARINGS TO REFERENCE OBJECTS ARE MAGNETIC & DISTANCES ARE TO A NAIL W/A REFERENCE TAG IN THE OBJECT, UNLESS OTHERWISE NOTED.

Signed by M.P. Davis Date 6/7/94

Surveyor's Michigan License No. 16926