

Approved by Delta County
 Land Survey Remonumentation
 Peer Group Under Act 345 Of
 P.A. Of 1990 On May 12, 1994
John Behmaling
 Acting Chairman

LAND CORNER RECORDATION CERTIFICATE
 Filing Requirement of Act 74, Mich. P.A. 1970

For corners in
DELTA
 (County)

Located In: Corner Code ##

- | | | |
|------------------------------------|-----------------------------|-----|
| 1. Public Land Survey | T <u>39</u> N R <u>24</u> W | J-7 |
| | T _____ R _____ | |
| | T _____ R _____ | |
| | T _____ R _____ | |
| 2. Property Controlling in Section | S _____ T _____ R _____ | |
| | S _____ T _____ R _____ | |
| 3. Miscellaneous Property in Sec. | S _____ T _____ R _____ | |
| | S _____ T _____ R _____ | |

MAY 13 1994

Recorded
 at 9:00 o'clock AM in Liber 7 Page 388
Walter C. Thuman Reg. of Deeds.
 Delta County, Michigan
 Register of Deeds Stamp & File Number

4. Lot No. _____, Recorded Plat _____
 5. Private Claims J-7 [N1/4 COR S.23] J-9 [N1/4 COR S.26]


	A	B	C	D	E	F	G	H	I	J	K	L	M
2	6	5	4	3	2	1							
3													
4	7	8	9	10	11	12							
5													
6	13	17	16	15	14	13							
7													
8	19	20	21	22	23	24							
9													
10	30	29	28	27	26	25							
11													
12	31	32	33	34	35	36							
13													

I, M.P. DAVIS, in a field survey on APRIL, 1994
 do hereby certify that under requirements of P.A. 74, Michigan P.A. of 1970, the corner points mentioned in lines 1 and 2 above were in conformance with regulations and rules therefore as required in the current manual of survey instructions of the United States Department of the Interior, Bureau of Land Management or by a decree of a Court of Law and/or that the corner points mentioned in lines 3, 4 and 5 above were in conformance with the rules of the Michigan Board of Land Surveyors or by a Decree of a Court of Law; established, re-established, monumented, re-monumented, recovered, found as expressed below:

NOTE: Not more than 4 corners, all in the same town and range, may be recorded on this certificate.

- A. Description of original monument and accessories and/or subsequent restoration:
 J-7 [N1/4 COR S.23] GEORGE ADAIR, D.S. - 1852 - WOOD POST (CEDAR 10"-S26°E-30 LINKS) (CEDAR 08"-N16°W-22 LINKS)
 D.A. BROTHERTON - 1896 - IDENTIFIED CORNER FROM ORIGINALS - NO NEW BT'S NOTED
 J.E. GINGRASS - 1906 - FOUND IRON STAKE IN PLACE & SET BY STAKES S43°W-16.5' & N43°E-16.5'
 M.S. McNABB - 1914 - FOUND IRON BOLT & BT STAKES IN PLACE
 J-9 [N1/4 COR S.26] GEORGE ADAIR, D.S. - 1852 - WOOD POST (HEMLOCK 16"-N33°E-20 LINKS) (HEMLOCK 15"-S33°W-17 LINKS)
 D.A. BROTHERTON - 1912 - RESET FROM N-S 1/4 LINE OF SEC 23 (NE COR HOUSE S34°51'W-120.9') (TREE IN ORCHARD 2"-N66°44'W-36.9')
 M.S. McNABB - 1919 - IDENTIFIED COR FROM PREVIOUS SURVEYS - NO NEW BT'S NOTED

- B. Description of corner evidence found and/or method applied in restoring or reestablishing corner:
 J-7 [N1/4 COR S.23] McNABB'S IRON STAKE RECOVER BY MYSELF IN 1973 & REC'D IN LCR'S L.1 PG. 407. CORNER MONUMENT & ACCESSORIES WERE DESTROYED DURING RECONSTRUCTION OF C.R. 537. RESET CORNER BY RETRACEMENT OF PRIVATE SURVEYS PERFORMED PREVIOUSLY. ACCEPTED AS BEING A CAREFUL AND FAITHFUL PERPETUATION OF THE POSITION OF THE ORIGINAL CORNER.
 J-9 [N1/4 COR S.26] FOUND IP AS ESTABLISHED BY MYSELF IN 1976 BY RETRACEMENT OF McNABB'S 1920 ROAD ALIGNMENT SURVEY OF C.R. 537 & REC'D IN LCR'S L.2 PG. 78. ACCEPTED AS BEING A CAREFUL & FAITHFUL REESTABLISHMENT OF THE POSITION OF THE ORIGINAL CORNER.

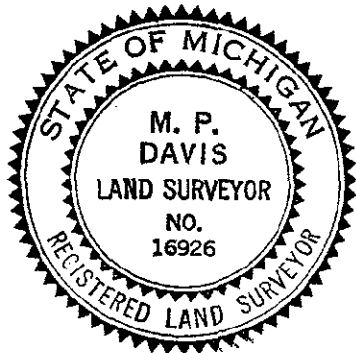

- C. Description of monument for corner and accessories established to perpetuate locating the position of the corner:
 J-7 SET, INSIDE A MON BOX, A 5/8" X 18" REBAR W/A 3-1/4" ALUMN CAP STAMPED TO ID THE CORNER POSITION.

MAPLE 16"	END GUARD RAIL POST	ELM 9"	SURVEY MONUMENT SIGN POST
S72°W	N17°E	S32°E	EAST
45.80'	87.19'	60.66'	25.33' (TO FACE)

 J-9 REPLACED IP W/A 5/8" X 18" REBAR W/A 3-1/4" ALUMN CAP STAMPED TO ID THE CORNER POSITION.

END GUARD RAIL POST	SURVEY MONUMENT SIGN POST	POWER POLE	NE COR OF HOUSE
N23°E	WEST	S78°E	S43°W
120.82'	10.34' (TO FACE)	58.18'	101.0'

NOTE: BEARINGS TO REFERENCE OBJECTS ARE MAGNETIC & DISTANCES ARE TO A NAIL W/A REFERENCE TAG IN THE OBJECT, UNLESS OTHERWISE NOTED.

Signed by M.P. Davis Date 5/2/94
 Surveyor's Michigan License No. 16926