


*Robert Schmeling*  
 Acting Chairman

**LAND CORNER RECORDATION CERTIFICATE**  
 Filing Requirement of Act 74, Mich. P.A. 1970

For corners in  
DELTA  
 (County)

Located in: \_\_\_\_\_ Corner Code ## \_\_\_\_\_

1. Public Land Survey T 39 N R 24 W J-11 6 

T \_\_\_\_\_ R \_\_\_\_\_  
 T \_\_\_\_\_ R \_\_\_\_\_

2. Property Controlling S \_\_\_\_\_ T \_\_\_\_\_ R \_\_\_\_\_  
 in Section S \_\_\_\_\_ T \_\_\_\_\_ R \_\_\_\_\_

3. Miscellaneous S \_\_\_\_\_ T \_\_\_\_\_ R \_\_\_\_\_  
 Property in Sec. S \_\_\_\_\_ T \_\_\_\_\_ R \_\_\_\_\_

4. Lot No. \_\_\_\_\_, Recorded Plat \_\_\_\_\_

5. Private Claims \_\_\_\_\_  
J-11 [N1/4 COR S.35] K-1 [NW COR S.1]

MAY 13 1994

Recorded \_\_\_\_\_  
 at 9:00 o'clock AM in Liber 7 Page 387  
*William C. Thomas* Reg. of Deeds.  
 Delta County, Michigan  
 Register of Deeds Stamp & File Number

A	B	C	D	E	F	G	H	I	J	K	L	M
2	6	5	4	3	2	1						
3												
4	7	8	9	10	11	12						
5												
6	18	17	16	15	14	13						
7												
8	19	20	21	22	23	24						
9												
10	30	29	28	27	26	25						
11												
12	31	32	33	34	35	36						
13												

I, M.P. DAVIS, in a field survey on APRIL, 19 94, do hereby certify that under requirements of P.A. 74, Michigan P.A. of 1970, the corner points mentioned in lines 1 and 2 above were in conformance with regulations and rules therefore as required in the current manual of survey instructions of the United States Department of the Interior, Bureau of Land Management or by a decree of a Court of Law and/or that the corner points mentioned in lines 3, 4 and 5 above were in conformance with the rules of the Michigan Board of Land Surveyors or by a Decree of a Court of Law; established, re-established, monumented, re-monumented, recovered, found as expressed below:


**NOTE: Not more than 4 corners, all in the same town and range, may be recorded on this certificate.**

A. Description of original monument and accessories and/or subsequent restoration:  
 J-11 [N1/4 COR S.35] GEORGE ADAIR, D.S. - 1852 - WOOD POST (Y. BIRCH 87°-N40°E-08 LINKS) (SPRUCE 10°-S60°W-12 LINKS)  
 D.A. BROTHERTON - 1912 - IDENTIFIED CORNER FROM FENCE POST & SCHOOL HOUSE LOT (ELM 5°-N25°15'W-32.9') (TELE POLES N35°E-29.5' & S73°50'W-39.5')  
 D.A. BROTHERTON - 1921 - IDENTIFIED FROM PREVIOUS SURVEY  
 H.S. McNABB - 1920 - RD ALIGNMENT SURVEY - ID CORNER POSITION BY STAKE IN PLACE (ELM 9°-N20°W-32.7') (TEL POLE-S78°W-39.5')  
 M. DAVIS - 1976 - RESTORED COR POSITION BY RETRACEMENT OF McNABB'S 1920 SURVEY & REC'D COR IN LCR'S L.2, PAGE 80

K-1 [NW COR S.1] JAMES H. MULLETTE, D.S. - 1848 - WOOD POST (CEDAR 12°-N70°E-06 LINKS) (BIRCH 06°-N33°W-06 LINKS)  
 GEORGE ADAIR, D.S. - 1852 - (CEDAR 12°-S41°E-13 LINKS) (CEDAR 08°-S49°W-16 LINKS)  
 H.S. McNABB - 1919 - IDENTIFIED CORNER BY STAKE IN PLACE & BT STAKES SET IN PREVIOUS SURVEYS - NO NEW BT'S NOTED

B. Description of corner evidence found and/or method applied in restoring or reestablishing corner:  
 J-11 [N1/4 COR S.35] ID CORNER POSITION BY IP IN MON BOX AS SET BY MYSELF IN 1976 BY RETRACEMENT OF McNABB'S 1920 SURVEY. ALL ACCESSORIES TO THE CORNER ESTABLISHED IN 1976 HAVE BEEN REMOVED BY IMPROVEMENTS. CORNER REC'D IN LCR'S L.2, PAGE 80. ACCEPTED AS BEING A CAREFUL & FAITHFUL REESTABLISHMENT OF THE POSITION OF THE ORIGINAL CORNER.

K-1 [NW COR S.1] ID N1/4 COR SEC 1 FROM LCR'S L.2 PG.474 - RAN WEST FROM N1/4 COR, FOUND McNABB'S 1919 W1/16 (CEDAR STAKE SCRIBED "1/8") EXTENDED LINE WEST FROM N1/4 COR & THRU THE W1/16 COR AND ESTABLISHED THE SEC COR ON THIS LINE & AT A PROPORTIONATE DISTANCE WEST OF THE W1/16 ACCEPTED AS BEING A CAREFUL & FAITHFUL REESTABLISHMENT OF THE POSITION OF THE ORIGINAL CORNER.

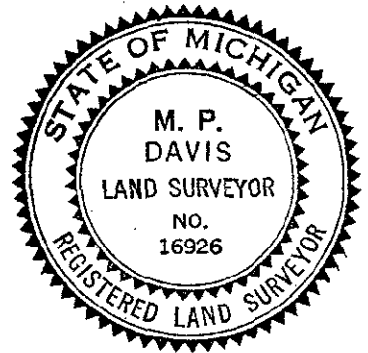

C. Description of monument for corner and accessories established to perpetuate locating the position of the corner:

J-11 REPLACED IP W/A 5/8" X 18" REBAR W/A 3-1/4" ALUMN CAP STAMPED TO ID THE CORNER POSITION

POWER POLE	POWER POLE	POWER POLE	SURVEY MONUMENT SIGN POST	C/L C.R. 537 NORTH
N58°W	N19°E	S25°E	SOUTH	WEST
90.57' (TO FACE)	40.71' (TO FACE)	27.93' (TO FACE)	18.28' (TO FACE)	31'

K-1 SET BERNTSEN AINB30 ALUMN MON WITH THE CAP STAMPED TO ID THE CORNER POSITION

CEDAR 12"	CEDAR 15'	CEDAR 5"	ASH 13"	SURVEY MONUMENT SIGN POST
N45°W	EAST	S36°E	S52°W	NORTH
78.62'	76.00'	34.46'	65.88'	3.30' (TO FACE)

NOTE: BEARINGS TO REFERENCE OBJECTS ARE MAGNETIC & DISTANCES ARE TO A NAIL W/A REFERENCE TAG IN THE OBJECT, UNLESS OTHERWISE NOTED.

Signed by M.P. Davis Date 5/2/94

Surveyor's Michigan License No. 16926