

LAND CORNER RECORDATION CERTIFICATE
Filing Requirement of Act 74, Mich. P.A. 1970

Robert C. Davis
Chairman

For corners in
DELTA
(County)

Located In: Corner Code #

- | | | |
|------------------------------------|-----------------------------|------------|
| 1. Public Land Survey | T <u>39</u> N R <u>24</u> W | <u>K-7</u> |
| | T _____ R _____ | |
| | T _____ R _____ | |
| | T _____ R _____ | |
| 2. Property Controlling in Section | S _____ T _____ R _____ | |
| | S _____ T _____ R _____ | |
| 3. Miscellaneous Property in Sec. | S _____ T _____ R _____ | |
| | S _____ T _____ R _____ | |

Recorded MAY 13 1994
at 9:00 o'clock AM in Liber 7 Page 386
William C. Thorne
Reg. of Deeds.
Delta County, Michigan
Register of Deeds Stamp & File Number

4. Lot No. _____, Recorded Plat _____
5. Private Claims X-6 [W1/4 COR S.13] K-7 [NW COR S.24]

A	B	C	D	E	F	G	H	I	J	K	L	M
2	6	5	4	3	2	1						
3												
4	7	8	9	10	11	12						
5												
6	18	17	16	15	14	13						
7												
8	19	20	21	22	23	24						
9												
10	30	29	28	27	26	25						
11												
12	31	32	33	34	35	36						
13												

I, M.P. DAVIS, in a field survey on APRIL, 1994, do hereby certify that under requirements of P.A. 74, Michigan P.A. of 1970, the corner points mentioned in lines 1 and 2 above were in conformance with regulations and rules therefore as required in the current manual of survey instructions of the United States Department of the Interior, Bureau of Land Management or by a decree of a Court of Law and/or that the corner points mentioned in lines 3, 4 and 5 above were in conformance with the rules of the Michigan Board of Land Surveyors or by a Decree of a Court of Law; established, re-established, monumented, re-monumented, recovered, found as expressed below:


NOTE: Not more than 4 corners, all in the same town and range, may be recorded on this certificate.

A. Description of original monument and accessories and/or subsequent restoration:
K-6 [W1/4 COR S.13] GEORGE ADAIR, D.S. - 1852 - WOOD POST (Y.BIRCH 25°-N45°W-13 LINKS) (BEECH 08°-S26°E-40 LINKS)
D.A.BROTHERTON - 1896 - IDENTIFIED CORNER POSITION FROM ORIGINALS - NO NEW WIT'S NOTED
M.S.McNABB - 1914 - FOUND STAKE IN PLACE (HEMLOCK 10° NE-57.3') (FENCE POST-NW-35.6')
M.DAVIS - 1976 - FOUND IRON BOLT IN PLACE & REC'D IN LCR'S L.2, PAGE 82

K-7 [NW COR S.24] GEORGE ADAIR, D.S. - 1852 - WOOD POST (HEMLOCK 22°-N39°E-20 LINKS) (CEDAR 18°-S31°W-30 LINKS)
D.A.BROTHERTON - 1896 - IDENTIFIED FROM ORIGINALS - NO NEW WIT'S NOTED
M.S.McNABB - 1914 - STAKE IN PLACE NO NEW WIT'S NOTED
M.DAVIS - 1976 - IP W/A SURVEY CAP & REC'D IN LCR'S L.2 PAGE 80

B. Description of corner evidence found and/or method applied in restoring or reestablishing corner:
K-6 [W1/4 COR S.13] FOUND IRON BOLT IN PLACE FROM PREVIOUS SURVEY WHICH IS NOW 30" M/L BELOW THE ROAD SURFACE-ALL ACCESSORIES ESTABLISHED PREVIOUSLY HAVE BEEN DESTROYED. ACCEPTED EXISTING MONUMENT AS BEING A CAREFUL & FAITHFUL PERPETUATION OF THE POSITION OF THE ORIGINAL CORNER.

K-7 [NW COR S.24] FOUND IP IN PLACE AS ESTABLISHED BY MYSELF IN 1976 BY IDENTIFY THE E1/4 COR OF SEC 14 & THE S1/16 COR ON THE E. LINE OF SEC 14 & EXTENDED A LINE FROM THE 1/4 COR THRU THE 1/16 COR & ESTABLISHING THE SEC COR ON THIS LINE AT A PROPORTIONATE DISTANCE SOUTH OF THE 1/16 CORNER. THIS CORNER INFORMATION WAS PREVIOUSLY RECORDED IN LCR'S L.2 PG. 80. ALL ACCESSORIES ESTABLISHED IN 1976 ARE DEAD OR HAVE BEEN REMOVED IN TIMBERING OPERATIONS. ACCEPTED THIS POSITION AS BEING A PERPETUATION OF THE POSITION OF THE ORIGINAL CORNER.

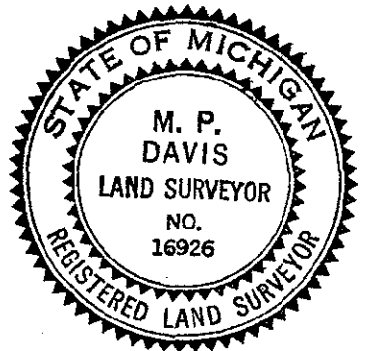

C. Description of monument for corner and accessories established to perpetuate locating the position of the corner:

- K-6 SET OVER EXISTING MON & 6" BELOW RD SURFACE A 5/8" X 18 REBAR W/A 3-1/4" ALUMN CAP STAMPED TO ID THE CORNER POSITION.
- | | | | |
|--------|-------------|------------|---------------------------|
| ELM 9" | ANCHOR POLE | POWER POLE | SURVEY MONUMENT SIGN POST |
| N33°E | S35°E | S46°W | EAST |
| 75.48' | 43.60' | 44.50' | 16.24' (TO FACE) |
- K-7 REPLACED EXISTING IP W/A 5/8" X 18" REBAR W/A 3-1/4" ALUMN CAP STAMPED TO ID THE CORNER POSITION & PLACED 6" M/L BELOW RD SURFACE
- | | | | | |
|----------|----------|-------------|-----------------|---------------------------|
| MAPLE 5" | MAPLE 5" | BASSWOOD 6' | MAPLE (TWIN) 6" | SURVEY MONUMENT SIGN POST |
| N59°W | N38°E | S25°E | S56°W | WEST |
| 21.91' | 26.26' | 26.31' | 44.81' | 13.75' (TO FACE) |

NOTE: BEARINGS TO REFERENCE OBJECTS ARE MAGNETIC & DISTANCES ARE TO A NAIL W/A REFERENCE TAG IN THE OBJECT, UNLESS OTHERWISE NOTED.

Signed by M.P. Davis Date 5/12/94
Surveyor's Michigan License No. 16926