

# SURVEY & REMONUMENTATION

SEP 13 1994

COMMISSION

Approved By Delta County  
Land Survey Remonumentation  
Peer Group Under Act 345 Of  
P.A. Of 1990 On May 19, 1994

## LAND CORNER RECORDATION CERTIFICATE

Filing Requirement of Act 74, Mich. P.A. 1970

*Robert Schmeling*  
Acting Chairman

For corners in  
DELTA  
(County)

Located In:

Corner Code ##

- |                                    |                         |                |
|------------------------------------|-------------------------|----------------|
| 1. Public Land Survey              | T 39 N R 24 W           | <u>K-8</u> K-9 |
|                                    | T _____ R _____         |                |
|                                    | T _____ R _____         |                |
|                                    | T _____ R _____         |                |
| 2. Property Controlling in Section | S _____ T _____ R _____ |                |
|                                    | S _____ T _____ R _____ |                |
| 3. Miscellaneous Property in Sec.  | S _____ T _____ R _____ |                |
|                                    | S _____ T _____ R _____ |                |

Recorded JUN - 8 1994  
at 9:00 o'clock AM in Liber 8 Page 5  
*William C. Thum*  
Reg. of Deeds.  
Delta County, Michigan  
Register of Deeds Stamp & File Number

4. Lot No. \_\_\_\_\_, Recorded Plat \_\_\_\_\_  
5. Private Claims K-8 [W1/4 COR S.24] K-9 [NW COR S.25]


	A	B	C	D	E	F	G	H	I	J	K	L	M
2	6	5	4	3	2	1							
3													
4	7	8	9	10	11	12							
5													
6	13	17	16	15	14	13							
7													
8	19	20	21	22	23	24							
9													
10	30	29	28	27	26	25							
11													
12	31	32	33	34	35	36							
13													

I, M.P. DAVIS, in a field survey on MAY, 19 94, do hereby certify that under requirements of P.A. 74, Michigan P.A. of 1970, the corner points mentioned in lines 1 and 2 above were in conformance with regulations and rules therefore as required in the current manual of survey instructions of the United States Department of the Interior, Bureau of Land Management or by a decree of a Court of Law and/or that the corner points mentioned in lines 3, 4 and 5 above were in conformance with the rules of the Michigan Board of Land Surveyors or by a Decree of a Court of Law; established, re-established, monumented, re-monumented, recovered, found as expressed below:

**NOTE: Not more than 4 corners, all in the same town and range, may be recorded on this certificate.**

- A. Description of original monument and accessories and/or subsequent restoration:  
 K-8 [W1/4 COR S.24] GEORGE ADAIR, D.S. - 1852 - WOOD POST (HEMLOCK 14"-N36°W-39 LINKS) (HEMLOCK 11"-S40°E-04 LINKS)  
 M.S.McNABB - 1913 - IDENTIFIED FROM RECORDS (ELM 4"-N10°E-7')  
 M.S.McNABB - 1919 - IN PLACE FROM PREVIOUS SURVEY - NO NEW WIT'S NOTED  
 K-9 [NW COR S.25] GEORGE ADAIR, D.S. - 1852 - WOOD POST (SUGAR 14"-N48°E-42 LINKS) (BEECH 16"-S57°W-27 LINKS)  
 M.S.McNABB - 1919 - LARGE POST 1' E. OF CORNER FENCE POST  
 FROM E.I.M. & W. RR R/W MAP C/L TRACK AT STA 2330+47 957' SOUTH OF CORNER

- B. Description of corner evidence found and/or method applied in restoring or reestablishing corner:  
 K-8 [W1/4 COR S.24] FOUND DRAG TOOTH IN PLACE AT POSITION INDICATED BY OCCUPATION & IMPROVEMENTS. MEASUREMENTS N & W TO ADJOINING CORNERS COMPARE WELL TO THE RECORDS OF McNABB, ACCEPTED EXISTING MONUMENT AS BEING THE BEST AVAILABLE EVIDENCE OF THE POSITION OF THE ORIGINAL CORNER.  
 K-9 [NW COR S.25] FOUND REMAINS OF WOOD POST 1' M/L EAST OF ANCIENT FENCE LINE N-S & W. DISTANCE WEST TO THE 1/4 COR CHECKS WELL WITH THE REC'DS OF McNABB. ACCEPTED EXISTING MONUMENT AS BEING THE BEST AVAILABLE EVIDENCE AS TO THE POSITION OF THE ORIGINAL CORNER.

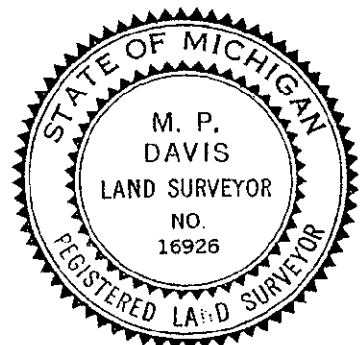

- C. Description of monument for corner and accessories established to perpetuate locating the position of the corner:  
 K-8 REPLACED EXISTING MON. W/A 5/8" X 18" REBAR W/A 3-1/4" ALUMN CAP STAMPED TO ID THE CORNER POSITION.  
 RED PINE 6" CEDAR 5" BALSAM 7" SPRUCE 9" SURVEY MONUMENT SIGN POST  
 S88°W N60°E S32°E S37°W EAST  
 30.05' 16.97' 47.81' 43.29' 8.32' (TO FACE)  
 K-9 SET A BERNTSEN AINB30 ALUMN MONUMENT WITH THE CAP STAMPED TO ID THE CORNER POSITION.  
 SURVEY MONUMENT SIGN POST SOUTH 3.42' (TO FACE)  
 NOTE: OPEN FIELDS SURROUND THE LOCATION OF THIS CORNER, THERE ARE NO WIT'S AVAILABLE.

NOTE: BEARINGS TO REFERENCE OBJECTS ARE MAGNETIC & DISTANCES ARE TO A NAIL W/A REFERENCE TAG IN THE OBJECT, UNLESS OTHERWISE NOTED.

Signed by M.P. Davis

Date 5/14/94

Surveyor's Michigan License No. 16926