

REMONUMENTATION

FEB 22 1996

COMMISSION

LAND CORNER RECORDATION CERTIFICATE  
Filing Requirement of Act 74, Mich. P.A. 1970

Approved By Delta County  
Land Survey Remonumentation  
Peer Group Under Act 345 Of  
P.A. Of 1990 On October 21, 1993  
*Robert Schumling*  
Acting Chairman

For corners in  
DELTA  
(County)

Located In: Corner Code #

DELTA COUNTY

LIBER 7 PAGE 323

93 DEC -2 AM 9:00

*William C. Thoman*  
REGISTER OF DEEDS

Register of Deeds Stamp & File Number

1. Public Land Survey	T 39 N R 23 W	A-4 & A-6
	T R	
	T <u>39N</u> R <u>24W</u>	<u>M-4</u>
	T R	
2. Property Controlling in Section	S T R	
	S T R	
3. Miscellaneous Property in Sec.	S T R	
	S T R	

4. Lot No. \_\_\_\_\_, Recorded Plat \_\_\_\_\_

5. Private Claims  
W1/4 COR SEC 7 & W1/4 COR SEC 18 - SAME AS M-4, M-6 T. 39N R24W


I, M.P. DAVIS, in a field survey on MAY, 19 93, do hereby certify that under requirements of P.A. 74, Michigan P.A. of 1970, the corner points mentioned in lines 1 and 2 above were in conformance with regulations and rules therefore as required in the current manual of survey instructions of the United States Department of the Interior, Bureau of Land Management or by a decree of a Court of Law and/or that the corner points mentioned in lines 3, 4 and 5 above were in conformance with the rules of the Michigan Board of Land Surveyors or by a Decree of a Court of Law; established, re-established, monumented, re-monumented, recovered, found as expressed below:

NOTE: Not more than 4 corners, all in the same town and range, may be recorded on this certificate.

- A. Description of original monument and accessories and/or subsequent restoration:
- A-4 [W1/4 COR SEC 7] JOHN BURT-1845-CORNER TREE(CEDAR 5") - CEDAR 2"-WEST-23 LINKS  
D.A. BROTHERTON-1908-NO EVIDENCE OF ORIGINALS FOUND ESTABLISHED COR POSITION BETWEEN SEC CORNERS-CEDAR POST BT-S67°W-29.2' - CEDAR POST-N65°E-30.5'
  - A-7 [W1/4 COR SEC 18] JOHN BURT-1845 -WOOD POST- BEECH 8"-S15°W-51 LINKS - Y.BIRCH 24"-N62°W-23 LINKS  
M.S. McNABB-1918-POST FOUND IN PLACE-RESET 5' IRON PIPE-HEMLOCK STUMP 12"-N62°E-51.2' - HEMLOCK STUMP 9"-S31°E-86.6'

A	B	C	D	E	F	G	H	I	J	K	L	M
2	6	5	4	3	2	1						
3												
4	7	8	9	10	11	12						
5												
6	18	17	16	15	14	13						
7												
8	19	20	21	22	23	24						
9												
10	30	29	28	27	26	25						
11												
12	31	32	33	34	35	36						
13												

- B. Description of corner evidence found and/or method applied in restoring or reestablishing corner:
- A-4 [W1/4 COR SEC 7] NO EVIDENCE OF CORNER POSITION FOUND- ESTABLISHED CORNER POSITION AT MIDPOINT BETWEEN SEC COR'S NORTH & SOUTH
  - A-7 [W1/4 COR SEC 18] NO EVIDENCE OF CORNER OF McNABB'S CORNER MONUMENT FOUND-FOUND HIS IRON PIPE MON AT THE 1/16 COR TO THE SOUTH & EXTENDED LINE NORTH FROM SW COR SEC 18 THROUGH THE S1/16 AND ESTABLISHED THE 1/4 COR ON THIS LINE & PROPORTIONATE DISTANCE NORTH OF THE 1/16 COR-THE PROPORTIONED DISTANCES COMPARE FAVORABLY WITH McNABB'S & D.A. BROTHERTON'S RECORD DISTANCES. ACCEPTED THIS POSITION AS BEING A CAREFUL & FAITHFUL REESTABLISHMENT OF THE POSITION OF THE ORIGINAL CORNER

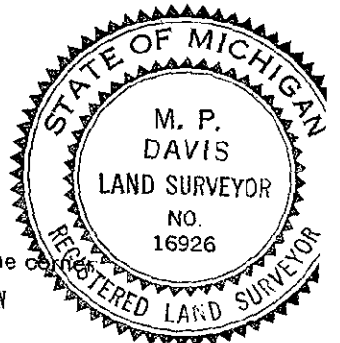

- C. Description of monument for corner and accessories established to perpetuate locating the position of the corner:
- A-4 PLACED INSIDE A MONUMENT BOX A 5/8" X 18" REBAR W/A 3-1/4" ALUMN CAP STAMPED TO ID THE CORNER POSITION  
CEDAR 5" CEDAR 8" CEDAR 10" POWER POLE SURVEY MONUMENT SIGN POST  
N16°W- N78°E S32°E S44°W EAST  
87.09' 37.05' 54.39' 59.35' (TO FACE) 33.0' (TO FACE)
  - A-6 PLACED INSIDE A MONUMENT BOX A 5/8" X 18" REBAR W/A 3-1/4" ALUMN CAP STAMPED TO ID THE CORNER POSITION  
TAMARACK 7" CEDAR 6" TAMARACK 8" SPRUCE 5" SURVEY MONUMENT SIGN POST  
N28°W N68°E S32°E S46°W WEST  
62.49' 48.22' 81.79' 60.57' 33.0' (TO FACE)

NOTE: BEARINGS TO REFERENCE OBJECTS ARE MAGNETIC & DISTANCE ARE TO A NAIL IN THE CENTER OF THE OBJECT UNLESS NOTED OTHERWISE

Signed by M.P. Davis

Date 10/10/93

Surveyor's Michigan License No. 16926

LIBER

7 PAGE 323