

JAN 4 1999

SECTION

LAND CORNER RECORDATION CERTIFICATE
Filing Requirement of Act 74, Mich. P.A. 1970

Approved By Delta County
Land Survey Remonumentation
Peer Group Under Act 345 Of
P.A. Of 1990 On 3-3, 1999
David B. Babbitt
Chairman

For corners in
DELTA
(County)

Located In: Corner Code #

- 1. Public Land Survey T 39 N R 18 W D - 1 SAME
T 40 N R 18 W D - 13 CORNER
T 39 N R 18 W D - 2
2. Property Controlling in Section S T R
3. Miscellaneous Property in Sec. S T R

Mar 4 1999
9:00 AM
9 138
Walter C. Thorne

Register of Deeds Stamp & File Number

- 4. Lot No. , Recorded Plat
5. Private Claims

D-1 [N1/4 COR SEC 5] D-2 [C1/4 COR SEC 5]

I, M.P. DAVIS, in a field survey on FEBRUARY, 19 99, do hereby certify that under requirements of P.A. 74, Michigan P.A. of 1970, the corner points mentioned in lines 1 and 2 above were in conformance with regulations and rules therefore as required in the current manual of survey instructions of the United States Department of the Interior, Bureau of Land Management or by a decree of a Court of Law and/or that the corner points mentioned in lines 3, 4 and 5 above were in conformance with the rules of the Michigan Board of Land Surveyors or by a Decree of a Court of Law; established, re-established, monumented, re-monumented, recovered, found as expressed below:

Grid table with columns A-M and rows 2-13. Contains numerical data points for survey locations.


NOTE: Not more than 4 corners, all in the same town and range, may be recorded on this certificate.

A. Description of original monument and accessories and/or subsequent restoration:

- D-1 [N1/4 COR SEC. 5] JOHN BURT, DS - 1845 - WOOD POST - (ASPEN 06° N09°E 07 LINKS)(FIR 05° N80°W 06 LINKS)
M.S.McNABB-1916-ROAD ALIGNMENT SURVEY- COUNTY ROAD 483-IRON STAKE IN PLACE 6' EAST OF C/L (FENCE POST EAST 24.2')(GUY POLE N72°W 34.2'
M.DAVIS,RLS-1971-REPLACED CORNER FROM McNABB'S BT FENCE POST-SET I.P. IN MON BOX (NO WIT'S NOTED)
NEIL HILL,RLS-1986-L.6 PG.117 LCR'S-FD IRON PIPE IN MON BOX REPLACE W/A COPPER CLAD IRON ROD (ANCHOR FENCE POST WEST 42.9')(2°I.P. S86°E 23.91')(PP N75°E 23.03')
D-2 [C1/4 COR SEC 5] NOT SET IN ORIGINALS
M.DAVIS,RLS-1970-L.1 PG. 27 LCR'S-SET I.P. IN MON BOX AT JCT OF 1/4 LINES (C/L COUNTY RD EAST 13.0')(IN LINE WITH FENCE WEST)
NEIL HILL,RLS-1986-L.6 PG.118 LCR'S-FD I.P. IN MON BOX (PP S80°E 44.69')(FENCE POST N75°E 53.06')(FENCE POST S55°E 57.6')(SIGN POST N20°W 66.54')

B. Description of corner evidence found and/or method applied in restoring or reestablishing corner:

- D-1 [N1/4 COR SEC. 5] FOUND IN PLACE AND INSIDE A MONUMENT BOX A 1" IRON PIPE AS SET BY MYSELF IN 1970 FROM McNABB'S CORNER FENCE POST BT. ID CORNER MONUMENT FROM BT'S REC'D AT L.6 OF LCR'S PG.117. ACCEPTED EXISTING MONUMENT AS BEING THE BEST AVAILABLE EVIDENCE AS TO THE LOCATION OF THE POSITION OF THE ORIGINAL CORNER.
D-2 [C1/4 COR SEC 5] FOUND IN PLACE AND INSIDE A MONUMENT BOX A 1" IRON PIPE AS SET BY MYSELF IN 1970. ID CORNER MONUMENT FROM BT'S REC'D AT L.6 OF LCR'S PG.118.

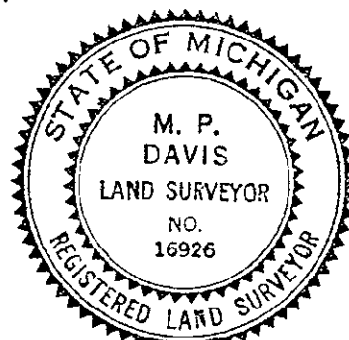

C. Description of monument for corner and accessories established to perpetuate locating the position of the corner:

- D-1 REPLACED EXISTING MONUMENT W/A 5/8" X 18" REBAR W/A 3 1/4" ALUM CAP STAMPED TO ID THE CORNER POSITION. SURVEY MONUMENT SIGN POST NOTE: FARM FIELDS IN ALL FOUR QUADRANTS. ASSESSORIES REC'D AT L.6 EAST LCR'S PG.117 ARE STILL IN PLACE AND VIABLE. 21.97' (TO FACE)
D-2 REPLACED EXISTING MONUMENT W/A 5/8" X 18" REBAR W/A 3 1/4" ALUM CAP STAMPED TO ID THE CORNER POSITION. 3" X 5" WOOD STOP SIGN POST SURVEY MONUMENT SIGN POST NOTE: BT'S REC'D AT L.6 OF LCR'S PG.118 ARE STILL IN PLACE AND VIABLE. N48°W WEST 33.43' 14.23' (TO FACE)

NOTE: BEARINGS TO REFERENCE OBJECTS ARE MAGNETIC-DISTANCES ARE TO A NAIL W/A DELTA COUNTY REFERENCE TAG, UNLESS OTHERWISE NOTED.

Signed by M.P. Davis Date 2/15/99
Surveyor's Michigan License No. 16926