

SURVEY & REMONUMENTATION

FEB 02 1999

SECTION

LAND CORNER RECORDATION CERTIFICATE
Filing Requirement of Act 74, Mich. P.A. 1970

Approved By Delta County
Land Survey Remonumentation
Peer Group Under Act 345 Of
P.A. Of 1990 On January 30, 1998
Robert Helmeling
Chairman

For corners in
DELTA
(County)

Located In: Corner Code #

1. Public Land Survey	T 40 N R 19 W	C - 5 ✓
	T 40 N R 19 W	C - 6
	T _____ R _____	_____
	T _____ R _____	_____
2. Property Controlling in Section	S _____ T _____ R _____	_____
	S _____ T _____ R _____	_____
3. Miscellaneous Property in Sec.	S _____ T _____ R _____	_____
	S _____ T _____ R _____	_____

Recorded Jan 11 1999
9:45 AM
9 132
Walter C. Thomas
Delta County, Reg. of Deeds

Register of Deeds Stamp & File Number

4. Lot No. _____, Recorded Plat _____
5. Private Claims C-5 [NW COR SEC 17] C-6 [W1/4 COR SEC 17]

A	B	C	D	E	F	G	H	I	J	K	L	M
2	6	5	4	3	2	1						
3												
4	7	8	9	10	11	12						
5												
6	18	17	16	15	14	13						
7												
8	19	20	21	22	23	24						
9												
10	30	29	28	27	26	25						
11												
12	31	32	33	34	35	36						
13												

I, M.P. DAVIS, in a field survey on DECEMBER, 19 98, do hereby certify that under requirements of P.A. 74, Michigan P.A. of 1970, the corner points mentioned in lines 1 and 2 above were in conformance with regulations and rules therefore as required in the current manual of survey instructions of the United States Department of the Interior, Bureau of Land Management or by a decree of a Court of Law and/or that the corner points mentioned in lines 3, 4 and 5 above were in conformance with the rules of the Michigan Board of Land Surveyors or by a Decree of a Court of Law; established, re-established, monumented, re-monumented, recovered, found as expressed below:

NOTE: Not more than 4 corners, all in the same town and range, may be recorded on this certificate.

A. Description of original monument and accessories and/or subsequent restoration:


C-5 [NW COR SEC. 17] A.MERRYWEATHER, DS - 1848 - WOOD POST - (TAMARACK 04° S40°E 15 LINKS)(TAMARACK 02° N60°W 08 LINKS)
NO RECORD OF SUBSEQUENT CORNER RECOVERY AND/OR MONUMENTATION

C-4 [W1/4 COR SEC 8] A.MERRYWEATHER,D.S. - 1848 - (SPRUCE 05° N85°E 70 LINKS) (SPRUCE 05°-S24°W-72 LINKS)
NO RECORD OF SUBSEQUENT CORNER RECOVERY AND/OR MONUMENTATION

B. Description of corner evidence found and/or method applied in restoring or reestablishing corner:

C-5 [NW COR SEC. 17] NO CORNER EVIDENCE FOUND. REESTABLISHED CORNER POSITION BY DOUBLE PROPORTIONATE MEASUREMENT BETWEEN SEC COR'S 1 MILE WEST, 2 MILES EAST, 2 MILES NORTH & 1 MILES SOUTH.

C-6 [W1/4 COR SEC 17] NO CORNER EVIDENCE FOUND. REESTABLISHED CORNER POSITION AT MIDPOINT BETWEEN AND ON LINE WITH SEC CORNERS 1/2 MILE NORTH & SOUTH.

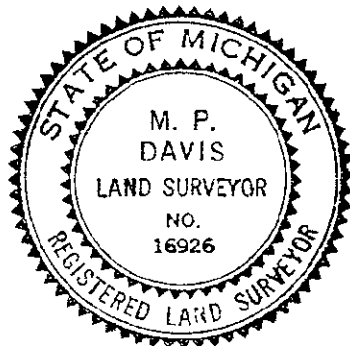

C. Description of monument for corner and accessories established to perpetuate locating the position of the corner:

C-5 SET BERNTSEN A1NB30 ALUM MONUMENT W/A 3 1/4" CAP STAMPED TO ID THE CORNER POSITION.
SURVEY MONUMENT SIGN POST NORTH 1.14' (TO FACE) NOTE: THIS CORNER POSITION FALLS IN OPEN MARSH LAND & BEAVER FLOODINGS. THERE ARE NO VIABLE WITNESS TREES WITHIN SEVERAL HUNDRED FEET.

C-6 SET BERNTSEN A1NB30 ALUMN MON. W/A 3 1/4" CAP STAMPED TO ID THE CORNER POSITION.
SURVEY MONUMENT SIGN POST NORTH 2.02' (TO FACE) NOTE: THIS CORNER POSITION FALLS IN A WIDE OPEN MARSH THERE ARE NO VIABLE WITNESS TREES WITHIN SEVERAL HUNDRED FEET.

NOTE: BEARINGS TO REFERENCE OBJECTS ARE MAGNETIC-DISTANCES ARE TO A NAIL W/A DELTA COUNTY REFERENCE TAG, UNLESS OTHERWISE NOTED.

Signed by M.P. Davis Date 12/29/98

Surveyor's Michigan License No. 16926