

SURVEY & REMONUMENTATION

FEB 02 1999

SECTION

LAND CORNER RECORDATION CERTIFICATE
Filing Requirement of Act 74, Mich. P.A. 1970

Approved By Delta County
Land Survey Remonumentation
Peer Group Under Act 345 Of
P.A. Of 1990 On December 30 1998

Walter C. Thomas
Delta County Chairman

For corners in

DELTA (County)	Located In:	Corner Code #
1. Public Land Survey	T 40 N R 19 W	D-1
	T 40 N R 19 W	D-3 ✓
	T _____ R _____	_____
	T _____ R _____	_____
	T _____ R _____	_____
2. Property Controlling in Section	S _____ T _____ R _____	_____
	S _____ T _____ R _____	_____
3. Miscellaneous Property in Sec.	S _____ T _____ R _____	_____
	S _____ T _____ R _____	_____

RECORDED Jan 4 1999
at 3:40 PM
Book 9 Page 119
Walter C. Thomas
Delta County, MI Reg. of Deeds

Register of Deeds Stamp & File Number

4. Lot No. _____, Recorded Plat _____
5. Private Claims _____
D-1 [N1/4 COR SEC 5] D-3 [N1/4 COR SEC 8]

A	B	C	D	E	F	G	H	I	J	K	L	M
2	6	5	4	3	2	1						
3												
4	7	8	9	10	11	12						
5												
6	18	17	16	15	14	13						
7												
8	19	20	21	22	23	24						
9												
10	30	29	28	27	26	25						
11												
12	31	32	33	34	35	36						
13												

I, M. P. DAVIS, in a field survey on DECEMBER, 19 98, do hereby certify that under requirements of P.A. 74, Michigan P.A. of 1970, the corner points mentioned in lines 1 and 2 above were in conformance with regulations and rules therefore as required in the current manual of survey instructions of the United States Department of the Interior, Bureau of Land Management or by a decree of a Court of Law and/or that the corner points mentioned in lines 3, 4 and 5 above were in conformance with the rules of the Michigan Board of Land Surveyors or by a Decree of a Court of Law; established, re-established, monumented, re-monumented, recovered, found as expressed below:

NOTE: Not more than 4 corners, all in the same town and range, may be recorded on this certificate.

A. Description of original monument and accessories and/or subsequent restoration:


D-1 [N1/4 COR SEC. 5] NOT SET IN ORIGINALS
NO RECORD OF SUBSEQUENT CORNER ESTABLISHMENT

D-3 [N1/4 COR SEC 8] A.MERRYWEATHER, D.S. - 1848 - (WILLOW 04' WEST 08 LINKS) (WILLOW 03'-N50'E-12 LINKS)
NO RECORD EVIDENCE OF SUBSEQUENT CORNER RECOVERY AND/OR RESTORATION

B. Description of corner evidence found and/or method applied in restoring or reestablishing corner:

D-1 [N1/4 COR SEC. 5] ESTABLISHED CORNER POSITION ON 4TH CORRECTION LINE NORTH AND AT MIDPOINT BETWEEN SECTION CORNERS 1/2 MILE EAST AND WEST.

D-3 [N1/4 COR SEC 8] NO CORNER EVIDENCE FOUND. REESTABLISHED CORNER POSITION AT MIDPOINT BETWEEN AND ON LINE WITH SECTION CORNERS 1/2 MILE EAST & WEST. THE CORNER IS LOCATED ON THE NORTHERLY SIDE OF A SMALL ISLAND OF CEDAR TREES SURROUNDED BY OPEN MARSH. AN ATTEMPT WAS MADE AT A COMPARISON DISTANCE TO THE "GLO" CALL FOR THE STREAM X-ING TO THE EAST, HOWEVER, DUE TO THE NUMEROUS SHARP MEANDERS EXISTING IN THE STREAM THE ATTEMPT FAILED AS A SMALL MIS-ALIGNMENT RESULTED IN A VARIETY OF DISTANCES.

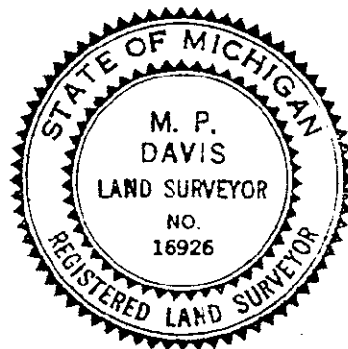

C. Description of monument for corner and accessories established to perpetuate locating the position of the corner:

D-1 SET BERNTSEN A1NB30 ALUM MONUMENT W/A 3 1/4" CAP STAMPED TO ID THE CORNER POSITION.
 JACK PINE 06" SPRUCE 05" JACK PINE 05" JACK PINE 06" SURVEY MONUMENT SIGN POST
 N12°E S69°E S51°W N60°W NORTH
 08.85' 12.03' 12.80' 20.70 1.82' (TO FACE)

D-3 SET BERNTSEN A1NB30 ALUMN MON. W/A 3 1/4" CAP STAMPED TO ID THE CORNER POSITION.
 CEDAR 06" CEDAR 05" ASH 07" SURVEY MONUMENT SIGN POST
 N54°E S54°E S15°W WEST
 27.02' 03.19' 28.57' 1.16' (TO FACE)

NOTE: BEARINGS TO REFERENCE OBJECTS ARE MAGNETIC-DISTANCES ARE TO A NAIL W/A DELTA COUNTY REFERENCE TAG, UNLESS OTHERWISE NOTED.

Signed by M.P. Davis Date 12/23/98
Surveyor's Michigan License No. 16926