

**SURVEY & REMONUMENTATION**

FEB 02 1999

**SECTION**

**LAND CORNER RECORDATION CERTIFICATE**  
Filing Requirement of Act 74, Mich. P.A. 1970

Approved By Delta County  
Land Survey Remonumentation  
Peer Group Under Act 345 Of  
P.A. Of 1990 On December 30, 1998  
*Robert A. Laveling*  
Chairman

For corners in  
DELTA  
(County)

Located In: Corner Code #

- |                                    |                             |       |
|------------------------------------|-----------------------------|-------|
| 1. Public Land Survey              | T <u>40</u> N R <u>19</u> W | H - 4 |
|                                    | T _____ R _____             | _____ |
|                                    | T _____ R _____             | _____ |
|                                    | T _____ R _____             | _____ |
| 2. Property Controlling in Section | S _____ T _____ R _____     | _____ |
|                                    | S _____ T _____ R _____     | _____ |
| 3. Miscellaneous                   | S _____ T _____ R _____     | _____ |
| Property in Sec.                   | S _____ T _____ R _____     | _____ |

Recorded Jan 4 1999  
at 3:30 o'clock PM  
Liber 9 Page 107  
*William G. Zimm*  
Delta County, Mich. Reg. of Deeds

Register of Deeds Stamp & File Number

4. Lot No. \_\_\_\_\_, Recorded Plat \_\_\_\_\_  
5. Private Claims H - 4 [C1/4 COR SEC 10]

A	B	C	D	E	F	G	H	I	J	K	L	M
2	6	5	4	3	2	1						
3												
4	7	8	9	•	11	12						
5												
6	18	17	16	15	14	13						
7												
8	19	20	21	22	23	24						
9												
10	30	29	28	27	26	25						
11												
12	31	32	33	34	35	36						
13												

I, M.P. DAVIS, in a field survey on DECEMBER, 19 98, do hereby certify that under requirements of P.A. 74, Michigan P.A. of 1970, the corner points mentioned in lines 1 and 2 above were in conformance with regulations and rules therefore as required in the current manual of survey instructions of the United States Department of the Interior, Bureau of Land Management or by a decree of a Court of Law and/or that the corner points mentioned in lines 3, 4 and 5 above were in conformance with the rules of the Michigan Board of Land Surveyors or by a Decree of a Court of Law; established, re-established, monumented, re-monumented, recovered, found as expressed below:


**NOTE: Not more than 4 corners, all in the same town and range, may be recorded on this certificate.**

A. Description of original monument and accessories and/or subsequent restoration:

H-4 [C1/4 SEC 10] NOT SET IN ORIGINALS  
M.S. McNABB - 1921 - "SET STAKE AT INTERSECTION OF 1/4 LINES" (CEDAR 9" S60°E 6.6')(CEDAR 9" N75°W 14.8')

B. Description of corner evidence found and/or method applied in restoring or reestablishing corner:

H-4 [C1/4 COR SEC 10] FOUND IN-PLACE REMAINS OF A POST POINT. ID CORNER POSITION FROM McNABB'S CEDAR SE NOW A STUMP WITH IRON MARKS PLAIN & THE NW CEDAR BT NOW 17" AND STILL GREEN WITH THE OVERGROWTH CONCEALING THE IRON MARKS. BY CURRENT MEASUREMENT THE EXISTING MONUMENT WAS FOUND TO BE 3.19' SOUTH & 5.04' EAST OF THE TRUE INTERSECTION OF THE 1/4 LINES. ACCEPTED THE EXISTING MONUMENT AS BEING THE TRUE CENTER OF THE SECTION AS IT FALLS WITHIN REASONABLE ACCURACY LIMITS AS OF THE DATE OF THE SURVEY.

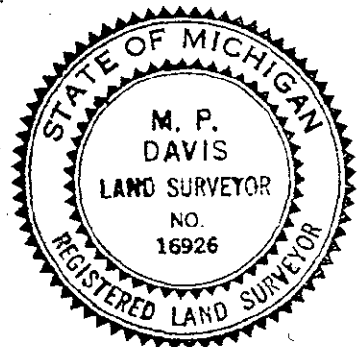

C. Description of monument for corner and accessories established to perpetuate locating the position of the corner:

H-4 REPLACED POST POINT W/ A BERNTSEN A1NB30 ALUMN MON W/A 3 1/4" ALUMN CAP STAMPED TO ID THE CORNER POSITION.

CEDAR 08"	CEDAR 08"	CEDAR 08"	CEDAR 17" (OLD BT)	SURVEY MONUMENT SIGN POST
N35°E	S52°E	S11°W	N75°W	NORTH
16.03'	6.56'	53.89'	15.22'	1.70' (TO FACE)

NOTE: BEARINGS TO REFERENCE OBJECTS ARE MAGNETIC-DISTANCES ARE TO A NAIL W/A DELTA COUNTY REFERENCE TAG, UNLESS OTHERWISE NOTED.

Signed by M.P. Davis Date 12/29/98  
Surveyor's Michigan License No. 16926