

OCT 26 1995

COMMISSION

Approved by Delta County
Land Survey Remonumentation
Peer Group Under Act 345 Of
P.A. Of 1990 On June 6, 1995
Walter C. Thorne
Delta County Chairman

LAND CORNER RECORDATION CERTIFICATE
Filing Requirement of Act 74, Mich. P.A. 1970

For corners in
DELTA
(County)

Located In: Corner Code ##

1. Public Land Survey	T <u>40 N</u> R <u>19 W</u>	H - 6 <u>H-8</u>
	T _____ R _____	_____
	T _____ R _____	_____
	T _____ R _____	_____
2. Property Controlling in Section	S _____ T _____ R _____	_____
	S _____ T _____ R _____	_____
3. Miscellaneous Property in Sec.	S _____ T _____ R _____	_____
	S _____ T _____ R _____	_____

Recorded 13 1995
at 9:00 o'clock A.M. in Liber 8 Page 62
Walter C. Thorne Reg. of Deeds.
Delta County, Michigan
Register of Deeds Stamp & File Number

4. Lot No. _____, Recorded Plat _____
5. Private Claims E-6 [C1/4 COR SEC 15] H-8 [C1/4 COR SEC 22]

	A	B	C	D	E	F	G	H	I	J	K	L	M
2	6	5	4	3	2	1							
3													
4	7	8	9	10	11	12							
5													
6	18	17	16	15	14	13							
7													
8	19	20	21	22	23	24							
9													
10	30	29	28	27	26	25							
11													
12	31	32	33	34	35	36							
13													

I, M.P. DAVIS in a field survey on JANUARY, 19 95, do hereby certify that under requirements of P.A. 74, Michigan P.A. of 1970, the corner points mentioned in lines 1 and 2 above were in conformance with regulations and rules therefore as required in the current manual of survey instructions of the United States Department of the Interior, Bureau of Land Management or by a decree of a Court of Law and/or that the corner points mentioned in lines 3, 4 and 5 above were in conformance with the rules of the Michigan Board of Land Surveyors or by a Decree of a Court of Law; established, re-established, monumented, re-monumented, recovered, found as expressed below:

NOTE: Not more than 4 corners, all in the same town and range, may be recorded on this certificate.

A. Description of original monument and accessories and/or subsequent restoration:


H-6 [C1/4 COR SEC. 15] NOT SET IN ORIGINALS
D.A. BROTHERTON - 1909 - ESTABLISHED CORNER POSITION AT MIDPOINT BETWEEN 1/4 COR'S. NORTH & SOUTH SET CEDAR STAKE & NOTED TWO PINE STUMP BT'S N12° 40'E. 26.8' & N55° 59'E. 40.8'
M.S. McNABB-1930-ID CORNER POSITION BY STAKE & BT'S IN PLACE AND SET IRON STAKE. NO NEW WIT'S NOTED.

H-8 [C1/4 COR SEC. 22] NOT SET IN ORIGINALS
M.S. McNABB-1930-ESTABLISHED CORNER POSITION 2640' SOUTH OF 1/4 CORNER & PARALLEL WITH WEST LINE OF THE SECTION. SET I.P AND WOOD STAKE FROM WHICH @ W.PINE 16°-N3°W-12.5' & W.PINE 9°-S30°E-11.3'

B. Description of corner evidence found and/or method applied in restoring or reestablishing corner:

H-6 [C1/4 COR SEC. 15] NO CORNER EVIDENCE FOUND AS POSITION FALLS IN A RED PINE PLANTATION. CORNER, CORNER MONUMENT & ACCESSORIES APPARENTLY DESTROYED IN PREPARATION FOR TREE PLANTING. REESTABLISHED CORNER POSITION AT MIDPOINT BETWEEN 1/4 CORNERS FOUND N & S. DISTANCE BETWEEN 1/4 CORNERS CHECK WELL WITH BROTHERTONS 1909 SURVEY.

H-8 [C1/4 COR SEC. 22] FOUND IN PLACE McNABB'S 1930 I.P. MONUMENT & NW W.PINE BT (NOW A STUMP WITH SCRIBE MARKS PLAIN)

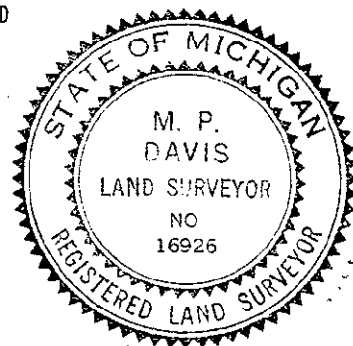

C. Description of monument for corner and accessories established to perpetuate locating the position of the corner:

H-6 SET A BERNTSEN ALNB30 ALUMN MON W/A 3 1/4" ALUMN CAP STAMPED TO ID THE CORNER POSITION.
SPRUCE 03" W. PINE 09" W. PINE 04" SURVEY MONUMENT SIGN POST
S88°W N13°W N89°E SOUTH
25.00' 36.00' 34.93' 3.04' (TO FACE)

H-7 SET A BERNTSEN ALNB30 ALUMN MON W/A 3 1/4" ALUMN CAP STAMPED TO ID THE CORNER POSITION.
SPRUCE 09" MAPLE 11" MAPLE 12" SURVEY MONUMENT SIGN POST
S35°E S58°E N64°W SOUTH
53.75' 33.28' 48.55' 2.21' (TO FACE)

NOTE: BEARINGS TO REFERENCE OBJECTS ARE MAGNETIC-DISTANCES ARE TO A NAIL W/A DELTA COUNTY REFERENCE TAG, UNLESS OTHERWISE NOTED.

Signed by M.P. Davis Date 4/13/95
Surveyor's Michigan License No. 16926