

SURVEY & REMONUMENTATION

FEB 02 1999

SECTION

LAND CORNER RECORDATION CERTIFICATE
Filing Requirement of Act 74, Mich. P.A. 1970

Approved By Delta County
Land Survey Remonumentation
Peer Group Under Act 345 Of
P.A. Of 1990 On December 30, 1998

Walter C. Thorne
Chairman

For corners in
DELTA
(County)

Located In: Corner Code #

1. Public Land Survey	T 40 N R19 W	L - 1
	T 40 N R19 W	L - 2 ✓
	T _____ R _____	_____
	T _____ R _____	_____
2. Property Controlling in Section	S _____ T _____ R _____	_____
	S _____ T _____ R _____	_____
3. Miscellaneous Property in Sec.	S _____ T _____ R _____	_____
	S _____ T _____ R _____	_____

Recorded Jan 4 1999
3:40 PM
9 116
Walter C. Thorne
Delta County, Michigan

Register of Deeds Stamp & File Number

4. Lot No. _____, Recorded Plat _____
5. Private Claims L-1 [N1/4 COR SEC 1] L-2 [C1/4 COR SEC 1]

A	B	C	D	E	F	G	H	I	J	K	L	M
2	6	5	4	3	2							
3												
4	7	8	9	10	11	12						
5												
6	18	17	16	15	14	13						
7												
8	19	20	21	22	23	24						
9												
10	30	29	28	27	26	25						
11												
12	31	32	33	34	35	36						
13												

I, M.P. DAVIS, in a field survey on DECEMBER, 19 98, do hereby certify that under requirements of P.A. 74, Michigan P.A. of 1970, the corner points mentioned in lines 1 and 2 above were in conformance with regulations and rules therefore as required in the current manual of survey instructions of the United States Department of the Interior, Bureau of Land Management or by a decree of a Court of Law and/or that the corner points mentioned in lines 3, 4 and 5 above were in conformance with the rules of the Michigan Board of Land Surveyors or by a Decree of a Court of Law; established, re-established, monumented, re-monumented, recovered, found as expressed below:

NOTE: Not more than 4 corners, all in the same town and range, may be recorded on this certificate.

A. Description of original monument and accessories and/or subsequent restoration:

L-1 [N1/4 COR SEC. 1] NOT SET IN ORIGINALS

M.S. McNABB - 1919 - ESTABLISHED ON 4TH CORRECTION LINE NORTH AT GOV'T DIST (469') EAST OF SW COR OF SEC 32 T41N R18W (CEDAR STUMP 18" N5°W 13.6')(CEDAR STUMP 20" S25°E 65.0')

M.S. McNABB - 1922 - SUBDIVISION OF SEC 1 T40N R18W "IT WAS DETERMINED THAT THE GOV'T DISTANCE OF 469.0' WAS IN ERROR & THAT THE CORRECT DISTANCE SHOULD BE 206.0' EAST OF THE SW COR OF SEC 32 T41N R18W." RESET CORNER WITH NO WIT'S NOTED OR DESCRIPTION OF MONUMENT GIVEN.

L-2 [C1/4 COR SEC. 1] NOT SET IN ORIGINALS.

M.S. McNABB - 1922 - ESTABLISHED C1/4 COR 2640.0 EAST OF WEST 1/4 COR SECTION 1 T40N R18W. SECT CEDAR STAKE WITH STONES PILED AROUND IT. (SPRUCE 6" N15°W 55.8')(CEDAR STUMP 18" N78°E 38")

M.S. McNABB - 1946 - STAKE IN PLACE FROM PREVIOUS SURVEY (CEDAR 6" S80°E 5.0')


B. Description of corner evidence found and/or method applied in restoring or reestablishing corner:

L-1 [N1/4 COR SEC. 1] NO CORNER EVIDENCE FOUND. RESTORED CORNER POSITION ON 4TH CORRECTION LINE

NORTH & 206.0' EAST OF SW CORNER OF SEC 32 T41N R18W. ID CEDAR BT STUMPS FROM McNABB'S ERRONEOUS 1919 CORNER AND FOUND IT TO MEASURE S63.8' FROM THE CORNER AS ESTABLISHED.

L-2 [C1/4 COR SEC. 1] FOUND IN PLACE POINTED REMAINS OF CEDAR STAKE IN STONE PILE. ID CORNER

MONUMENT FROM McNABB'S CEDAR STUMP BY NE & CEDAR BT SE. MEASUREMENT WEST TO W1/4 COR WAS FOUND TO BE 2637.5' (McNABB 2640')

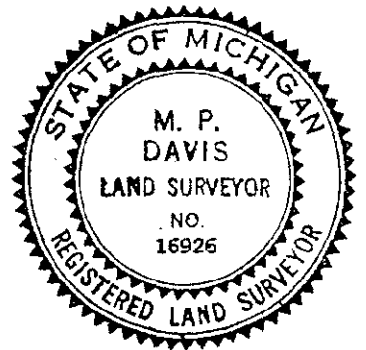

C. Description of monument for corner and accessories established to perpetuate locating the position of the corner:

L-1 SET BERNTSEN ALNB30 ALUMN MON. W/A 3 1/4" CAP STAMPED TO ID THE CORNER POSITION.

CEDAR 12"	SPRUCE 05"	SPRUCE 06"	SW COR SEC 32 T41N R18W	SURVEY MONUMENT SIGN POST
N72°E	S30°E	S37°W	WEST	NORTH
25.28'	10.63'	14.94'	206.0'	1.19' (TO FACE)

L-2 SET, IN THE POST POINT, A 5/8" X 18" REBAR W/A 2" ALUM CAP STAMPED TO ID THE CORNER POSITION.

SPRUCE 11"	SPRUCE 10"	BALSAM 06"	SPRUCE 11"
N60°E	S22°E	S48°W	N74°W
14.53'	09.72'	11.96'	22.68'

NOTE: BEARINGS TO REFERENCE OBJECTS ARE MAGNETIC-DISTANCES ARE TO NAIL W/A DELTA COUNTY REFERENCE TAG, UNLESS OTHERWISE NOTED.

Signed by M.P. Davis Date 12/28/98

Surveyor's Michigan License No. 16926