SURVEY &
REMONUMENTATION
NOV 1 8 1998

INVENTORY
GLO SURVEY CORNERS
DELTA COUNTY MICHIGAN

SECTION

TOTAL NO. SECTION CORNERS ESTABLISHED 18 RE ESTABLISHED 7

TOTAL NO. 1/4 CORNERS ESTABLISHED 37 RE ESTABLISHED 6

TOTAL NO. MEANDER CORNERS ESTABLISHED 26 RE ESTABLISHED 0
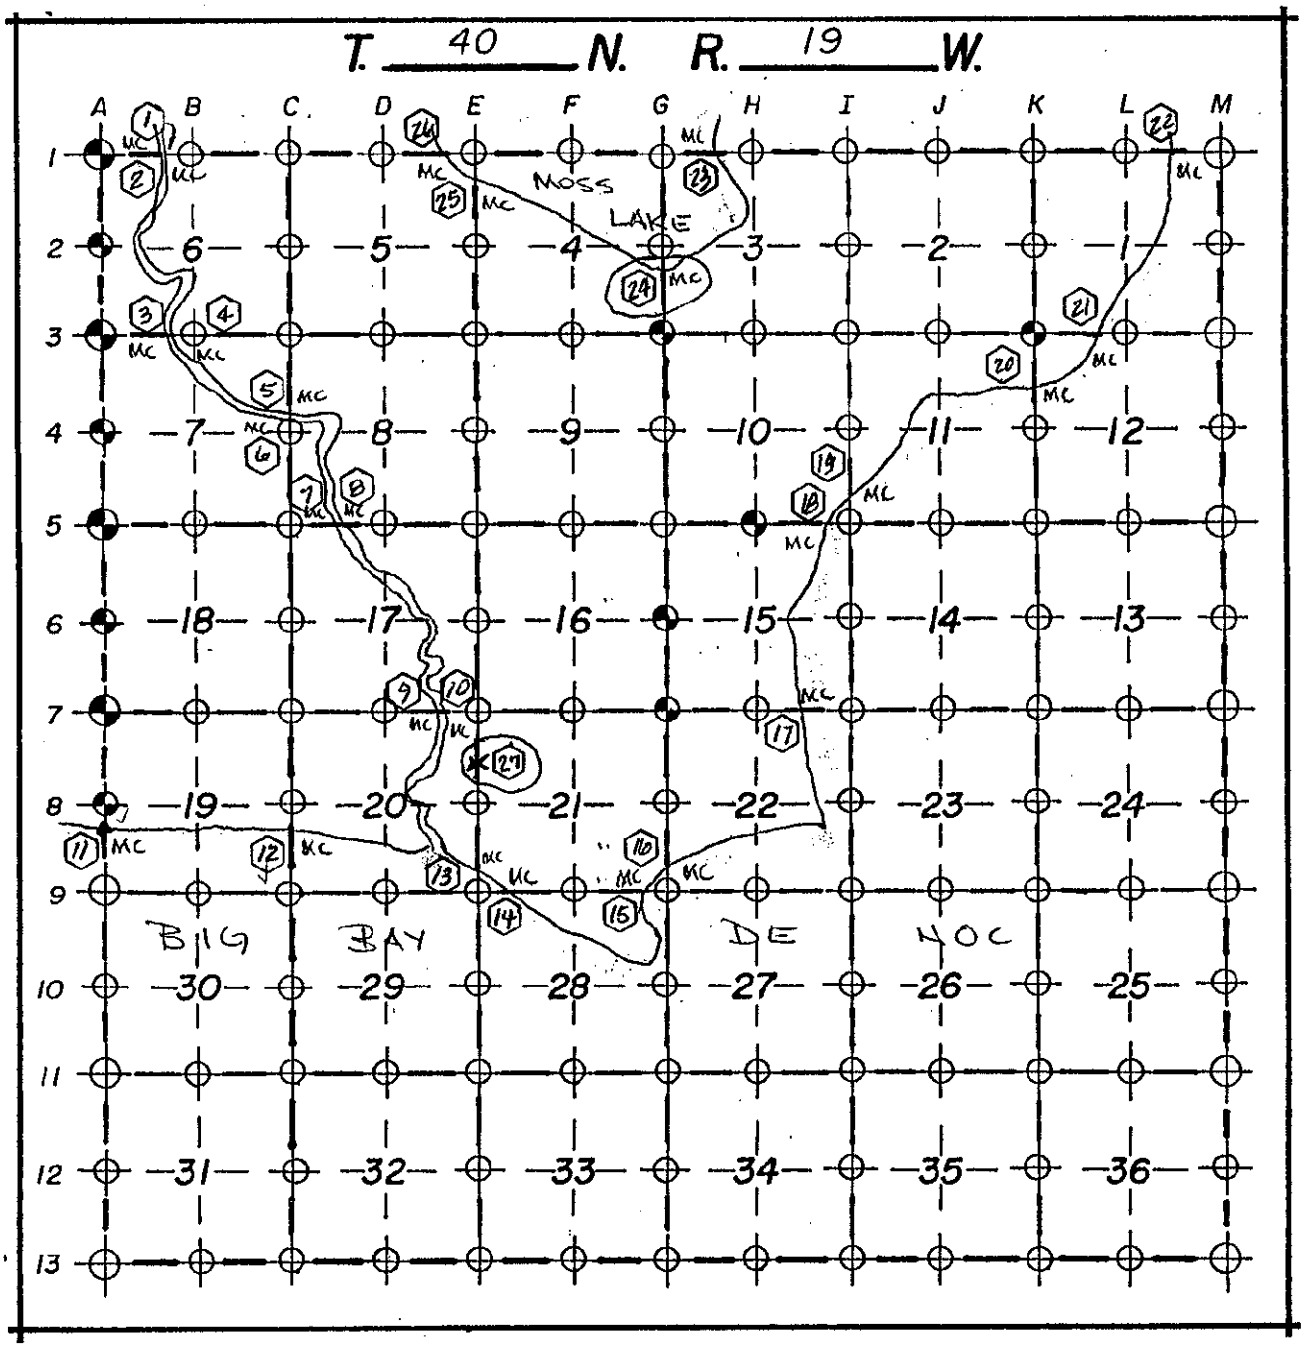
⬡ INDICATES M.C. NUMBERING SYSTEM