

7-348

SURVEY & REMONUMENTATION

FEB 18 1994

COMMISSION

Approved By Delta County Land Survey Remonumentation Peer Group Under Act 345 Of P.A. Of 1990 On January 20, 1994
Robert A. Hummel
acting Chairman

LAND CORNER RECORDATION CERTIFICATE
Filing Requirement of Act 74, Mich. P.A. 1970

For corners in

DELTA
(County)

Located In:

Corner Code ##

1. Public Land Survey	T	<u>40 N</u>	R	<u>22 W</u>	<u>C-4 & E-4</u>
	T		R		
	T		R		
	T		R		
2. Property Controlling in Section	S		T	R	
	S		T	R	
3. Miscellaneous Property in Sec.	S		T	R	
	S		T	R	

Recorded January 21, 1994
at 9:00 o'clock a.m. in Liber 7 Page 348
William C. Thuman Reg. of Deeds.
Delta County, Michigan
Register of Deeds Stamp & File Number

- 4. Lot No. _____, Recorded Plat _____
- 5. Private Claims _____
[C-4] W1/4 COR SEC 8 [E-4] W1/4 COR SEC 9

A	B	C	D	E	F	G	H	I	J	K	L	M
2	6	5	4	3	2	1						
3												
4	7	8	9	10	11	12						
5												
6	13	17	16	15	14	13						
7												
8	19	20	21	22	23	24						
9												
10	30	29	28	27	26	25						
11												
12	31	32	33	34	35	36						
13												

I, M.P. DAVIS, in a field survey on NOVEMBER, 19 93, do hereby certify that under requirements of P.A. 74, Michigan P.A. of 1970, the corner points mentioned in lines 1 and 2 above were in conformance with regulations and rules therefore as required in the current manual of survey instructions of the United States Department of the Interior, Bureau of Land Management or by a decree of a Court of Law and/or that the corner points mentioned in lines 3, 4 and 5 above were in conformance with the rules of the Michigan Board of Land Surveyors or by a Decree of a Court of Law; established, re-established, monumented, re-monumented, recovered, found as expressed below:

NOTE: Not more than 4 corners, all in the same town and range, may be recorded on this certificate.


A. Description of original monument and accessories and/or subsequent restoration:
C-4 [W1/4 COR SEC 8] WOOD POST - A. MERRYWEATHER, D.S. - 1846 (NORWAY PINE 14"-S41°W-120 LINKS) (SPRUCE PINE 8"-S29°E-94 LINKS)
D.A. BROTHERTON - 1895 - ID CORNER POSITION BY EXISTING STAKE & BOTH "ORIGINAL" BT'S
M.S. McNAEB - 1932 - FOUND STAKE AT FENCE CORNER - NO NEW WIT'S NOTED

E-4 [W1/4 COR SEC 9] WOOD POST - A. MERRYWEATHER, D.S. - 1846 (NORWAY PINE 26"-S80°W-1.59 CHS) (NORWAY PINE 26"-N30°E-1.52 CHS)
NO RECCRD EVIDENCE OF SUBSEQUENT MONUMENTATION OF THE CORNER POSITION

B. Description of corner evidence found and/or method applied in restoring or reestablishing corner:

C-4 [W1/4 COR SEC 8] NO EVIDENCE OF COR MON FOUND - RESET COR BY EXTENDING LINE EAST FROM THE W1/4 COR OF SEC 7 THRU THE C1/4 COR AND ESTABLISHING THE NEW CORNER POSITION ON THIS LINE AT A PROPORTIONATE DISTANCE EAST OF THE C1/4 COR - BASED ON THE 1932 MEASUREMENTS OF M.S. McNAEB. ACCEPTED THIS POSITION AS BEING A CAREFUL AND FAITHFUL PERPETUATION OF THE POSITION OF THE ORIGINAL CORNER

E-4 [W1/4 COR SEC 9] FOUND IN PLACE A 2" GALV I.P. W/A 3" BRASS CAP STAMPED TO ID THE CORNER POSITION - CAP HAS NO DATE OR THE NAME OF THE SCRIVENER STAMPED THEREON - ID CORNER MON FROM THE PLAT OF MARBLE HIGHLAND NO. 2 AS RECORDED IN LIBER "C" OF PLAT'S PG'S 40-42 ACCEPTED EXISTING MON AS A CAREFUL & FAITHFUL RESTABLISHMENT OF THE POSITION OF THE ORIGINAL COR

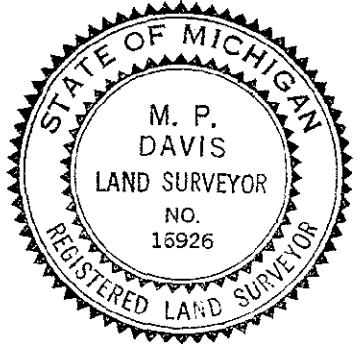

C. Description of monument for corner and accessories established to perpetuate locating the position of the corner:

C-4 SET A 4" X 4" X 36 CONC MON W/A BRASS CAP STAMPED TO ID THE CORNER POSITION
RED PINE 7" RED PINE 10" JACK PINE 10" SURVEY MONUMENT SIGN POST
N36°E S74°E S4°W N45°W
13.15' 7.70' 63.02' 1.73' (TO FACE)

E-4 DID NOT DISTURB EXISTING MONUMENT
OAK 6" OAK 22" OAK 4" SURVEY MONUMENT SIGN POST
N14°W N64°E S33°E S51°W
22.14' 12.12' 13.79' 2.46' (TO FACE)

NOTE: BEARINGS TO REFERENCE OBJECTS ARE MAGNETIC & DISTANCES ARE TO A NAIL IN THE CENTER OF THE OBJECT UNLESS OTHERWISE NOTED

Signed by M.P. Davis Date 11/15/93
Surveyor's Michigan License No. 16926