

FEB 18 1994

COMMISSION

7-356

Approved By Delta County Land Survey Remonumentation Peer Group Under Act 345 Of P.A. Of 1990 On Jan. 20, 1994
Robert Robinson
Chairman

LAND CORNER RECORDATION CERTIFICATE
Filing Requirement of Act 74, Mich. P.A. 1970

For corners in

<u>DELTA</u> (County)	Located in:	Corner Code #
1. Public Land Survey	T <u>40 N</u> R <u>22 W</u>	<u>B-7 & C-6</u>
	T _____ R _____	_____
	T _____ R _____	_____
	T _____ R _____	_____
2. Property Controlling in Section	S _____ T _____ R _____	_____
	S _____ T _____ R _____	_____
3. Miscellaneous Property in Sec.	S _____ T _____ R _____	_____
	S _____ T _____ R _____	_____

Recorded January 21, 1994
at 9:00 o'clock a.m. in Lib 7 Page 356
Walter C. Thuman
Reg. of Deeds.
Delta County, Michigan
Register of Deeds Stamp & File Number

- 4. Lot No. _____, Recorded Plat _____
- 5. Private Claims _____
[B-7] N1/4 COR SEC 19 [C-6] W1/4 COR SEC 17


	A	B	C	D	E	F	G	H	I	J	K	L	M
2	6	5	4	3	2	1							
3													
4	7	8	9	10	11	12							
5													
6	18	17	16	15	14	13							
7													
8	19	20	21	22	23	24							
9													
10	30	29	28	27	26	25							
11													
12	31	32	33	34	35	36							
13													

I, M.P. DAVIS, in a field survey on NOVEMBER, 1993, do hereby certify that under requirements of P.A. 74, Michigan P.A. of 1970, the corner points mentioned in lines 1 and 2 above were in conformance with regulations and rules therefore as required in the current manual of survey instructions of the United States Department of the Interior, Bureau of Land Management or by a decree of a Court of Law and/or that the corner points mentioned in lines 3, 4 and 5 above were in conformance with the rules of the Michigan Board of Land Surveyors or by a Decree of a Court of Law; established, re-established, monumented, re-monumented, recovered, found as expressed below:

NOTE: Not more than 4 corners, all in the same town and range, may be recorded on this certificate.

- A. Description of original monument and accessories and/or subsequent restoration:
B-7 [N1/4 COR SEC 19] WOOD POST - A. MERRYWEATHER, D.S. - 1846 (SPRUCE PINE 8"-N8°W-2.52 CHS) (SPRUCE PINE 6"-S20°W-2.14 CHS)
M.S. MCNABB-1934 ROAD ALIGNMENT SURVEY FOR ESCANABA TWP.-FOUND IP IN PLACE (JACK PINE 4"-N15°E-32.5') (JACK PINE 4"-S45°W-65.4')
- C-6 [W1/4 COR SEC 17] WOOD POST - A. MERRYWEATHER, D.S. - 1846 (POPLAR 6"-S50°W-84 LINKS) (BURNT PINE 18"-N36°E-82 LINKS)
NO RECORD EVIDENCE OF SUBSEQUENT RESTORATION OF CORNER POSITION

- B. Description of corner evidence found and/or method applied in restoring or reestablishing corner:
B-7 [N1/4 COR SEC 19] FOUND IP IN PLACE AS CALLED FOR IN MCNABB'S FIELD NOTES
ACCEPTED EXISTING MON AS A CAREFUL & FAITHFUL REESTABLISHMENT OF THE POSITION OF THE ORIGINAL CORNER
- C-6 [W1/4 COR SEC 17] FOUND CONC MONUMENT 0.38' SOUTH & 0.53' WEST OF MID POINT BETWEEN SEC COR'S
ACCEPTED EXISTING MON AS A CAREFUL & FAITHFUL REESTABLISHMENT OF THE POSITION OF THE ORIGINAL CORNER

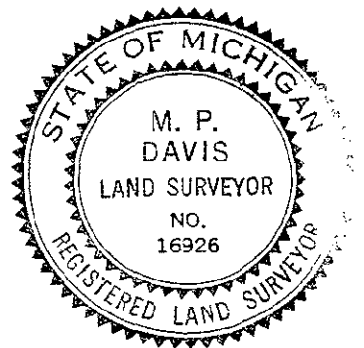

- C. Description of monument for corner and accessories established to perpetuate locating the position of the corner:
B-7 SET, OVER EXISTING MON. A 5/8" X 18" REBAR W/A 3-1/4" ALUM CAP STAMPED TO ID THE COR POSITION & RAISED TO RD SURFACE W/A MON B'
POWER POLE OAK 14" OAK 15" SURVEY MONUMENT SIGN POST
N36°W S52°E S34°W NORTH
37.05' 60.08' 59.95' 29.70' (TO FACE)
- C-6 DID NOT DISTURB EXISTING MONUMENT
JACK PINE 5" JACK PINE 6" JACK PINE 4" JACK PINE 10" SURVEY MONUMENT SIGN POST
N23°W N50°E S28°E S52°W WEST
21.11' 18.20' 40.80' 27.34' 1.63' (TO FACE)

NOTE: BEARINGS TO REFERENCE OBJECTS ARE MAGNETIC & DISTANCES ARE TO A NAIL IN THE CENTER OF THE OBJECT UNLESS OTHERWISE NOTED

Signed by M.P. Davis Date 11/15/93
Surveyor's Michigan License No. 16926