

FEB 18 1994

COMMISSION

LAND CORNER RECORDATION CERTIFICATE  
Filing Requirement of Act 74, Mich. P.A. 1970

Approved By Delta County  
Land Survey Remonumentation  
Peer Group Under Act 345 Of  
P.A. Of 1990 On Jan 20, 1994  
*Robert Schumaker*  
Acting Chairman

For corners in

DELTA  
(County)

Located In:

Corner Code ##

- 1. Public Land Survey T 40 N R 22 W F-3 & (E-5)  
T \_\_\_\_\_ R \_\_\_\_\_  
T \_\_\_\_\_ R \_\_\_\_\_  
T \_\_\_\_\_ R \_\_\_\_\_
- 2. Property Controlling S \_\_\_\_\_ T \_\_\_\_\_ R \_\_\_\_\_  
in Section S \_\_\_\_\_ T \_\_\_\_\_ R \_\_\_\_\_
- 3. Miscellaneous S \_\_\_\_\_ T \_\_\_\_\_ R \_\_\_\_\_  
Property in Sec. S \_\_\_\_\_ T \_\_\_\_\_ R \_\_\_\_\_

Recorded January 21, 1994  
9:00 o'clock A.M. in Liber 7 Page 347  
*Walter C. Thoman* Reg. of Deeds.  
Delta County, Michigan  
Register of Deeds Stamp & File Number

- 4. Lot No. \_\_\_\_\_, Recorded Plat \_\_\_\_\_
- 5. Private Claims \_\_\_\_\_  
[F-3] N1/4 COR SEC 9 [E-5] NW COR OF SEC 16


A	B	C	D	E	F	G	H	I	J	K	L	M
2	6	5	4	3	2	1						
3												
4	7	8	9	10	11	12						
5												
6	18	17	16	15	14	13						
7												
8	19	20	21	22	23	24						
9												
10	30	29	28	27	26	25						
11												
12	31	32	33	34	35	36						
13												

I, M.P. DAVIS, in a field survey on NOVEMBER, 19 93, do hereby certify that under requirements of P.A. 74, Michigan P.A. of 1970, the corner points mentioned in lines 1 and 2 above were in conformance with regulations and rules therefore as required in the current manual of survey instructions of the United States Department of the Interior, Bureau of Land Management or by a decree of a Court of Law and/or that the corner points mentioned in lines 3, 4 and 5 above were in conformance with the rules of the Michigan Board of Land Surveyors or by a Decree of a Court of Law; established, re-established, monumented, re-monumented, recovered, found as expressed below:

**NOTE: Not more than 4 corners, all in the same town and range, may be recorded on this certificate.**

- A. Description of original monument and accessories and/or subsequent restoration:  
F-3 [N1/4 COR SEC 9] WOOD POST - A. MERRYWEATHER, D.S. - 1846 (HEMLOCK 20"-WEST-31 LINKS) (W.PINE 12"-S70°E-53 LINKS)  
M.S. McNABB - 1944 - ESTABLISHED COR POSITION IN C.L. OF N-S COUNTY ROAD WHERE RECORDS SAID COR STOOD PRIOR TO RD CONSTR DROVE  
IRON STAKE - FENCE POSTS S35°W-55.8' & S65°E-39.6'
- E-5 [NW COR SEC 16] WOOD POST - A. MERRYWEATHER, D.S. - 1846 (NORWAY PINE 26"-N26°E-62 LINKS) (BLACK OAK 11'-S45°W-56 LINKS)  
M.S. McNABB - 1944 - COR IN PLACE - NO NEW WIT'S NOTED OR DESCRIPTION OF MON FOUND GIVEN IN HIS NOTES

- B. Description of corner evidence found and/or method applied in restoring or reestablishing corner:  
F-3 [N1/4 COR SEC 9] NO EVIDENCE OF McNABB'S IRON STAKE FOUND - RESET CORNER POSITION AT McNABB'S DISTANCE WEST OF THE NE COR OF SEC 9 & IN LINE WITH ANCIENT FENCE LINE TO THE WEST ACCEPTED THIS POSITION AS A CAREFUL & FAITHFUL REESTABLISHMENT OF THE POSITION OF THE ORIGINAL CORNER.
- E-5 [NW COR SEC 16] FOUND AXEL SHAFT IN PLACE - ID CORNER POSITION FROM PLAT OF MARBLE HIGHLANDS AS RECORDED IN LIBER "C" OF PLATS PAGE 38. ACCEPTED AS BEING A CAREFUL & FAITHFULL REESTABLISHMENT OF THE POSITION OF THE ORIGINAL CORNER.

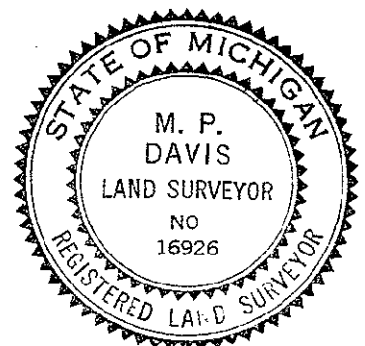

- C. Description of monument for corner and accessories established to perpetuate locating the position of the corner:  
F-3 SET, INSIDE A MON BOX, A 5/8" X 18" REBAR W/A 3-1/4' ALUMN CAP STAMPED TO ID THE CORNER POSITION  
W. PINE 7" 2" I.P. SURVEY MONUMENT SIGN POST  
N37°E EAST WEST  
58.45' 36.88' 9.65' (TO FACE)
- E-5 SET, OVER EXISTING MON, A BERNTSEN ALNB30 ALUMN MON W/A CAP STAMPED TO ID THE CORNER POSITION  
ST. SIGN POST POWER POLE POWER POLE SURVEY MONUMENT SIGN POST  
N24°W S21°W S34°W WEST  
42.80' 77.25' 33.25' (TO FACE) 10.57' (TO FACE)

NOTE: BEARINGS TO REFERENCE OBJECTS ARE MAGNETIC & DISTANCES ARE TO A NAIL IN THE CENTER OF THE OBJECT UNLESS OTHERWISE NOTED

Signed by M.P. Davis Date 11/15/93

Surveyor's Michigan License No. 16926