

SURVEY & REMONUMENTATION

FEB 18 1994

COMMISSION

LAND CORNER RECORDATION CERTIFICATE
Filing Requirement of Act 74, Mich. P.A. 1970

Approved by Delta County
 Land Survey Remonumentation
 Peer Group Under Act 345 Of
 P.A. Of 1990 On Jan 20, 1994
David A. Kinsling
 Acting Chairman

For corners in

DELTA (County)	Located In:	Corner Code #
1. Public Land Survey	T <u>40 N</u> R <u>22 W</u>	<u>G-2 G I-2</u>
	T _____ R _____	_____
	T _____ R _____	_____
	T _____ R _____	_____
2. Property Controlling in Section	S _____ T _____ R _____	_____
	S _____ T _____ R _____	_____
3. Miscellaneous Property in Sec.	S _____ T _____ R _____	_____
	S _____ T _____ R _____	_____

Recorded January 21, 1994
 at 9:00 o'clock a.m. in Liber 7 Page 345
William C. Thorne Reg. of Deeds.
 Delta County, Michigan
 Register of Deeds Stamp & File Number

4. Lot No. _____, Recorded Plat _____
 5. Private Claims _____
[G-2] W1/4 COR SEC 3 [I-2] W1/4 COR SEC 2

	A	B	C	D	E	F	G	H	I	J	K	L	M
2	6	5	4	3	2	1							
3													
4	7	8	9	10	11	12							
5													
6	13	14	15	16	17	18							
7													
8	19	20	21	22	23	24							
9													
10	30	29	28	27	26	25							
11													
12	31	32	33	34	35	36							
13													

I, M. P. DAVIS, in a field survey on NOVEMBER, 1993, do hereby certify that under requirements of P.A. 74, Michigan P.A. of 1970, the corner points mentioned in lines 1 and 2 above were in conformance with regulations and rules therefore as required in the current manual of survey instructions of the United States Department of the Interior, Bureau of Land Management or by a decree of a Court of Law and/or that the corner points mentioned in lines 3, 4 and 5 above were in conformance with the rules of the Michigan Board of Land Surveyors or by a Decree of a Court of Law; established, re-established, monumented, re-monumented, recovered, found as expressed below:


NOTE: Not more than 4 corners, all in the same town and range, may be recorded on this certificate.

A. Description of original monument and accessories and/or subsequent restoration:

- G-2 [W1/4 COR SEC 3] WOOD POST - A. MERRYWEATHER, D.S. - 1846 (TAMERAC 6°-S20°E-20 LINKS) (CEDAR 6°-NORTH-25 LINKS)
 M.S. McNABB - 1944 - FOUND WOOD STAKE IN ROAD BED - FENCE LINE NORTH - DROVE IRON STAKE - NO WIT'S NOTED
- I-2 [W1/4 COR SEC 2] WOOD POST - A. MERRYWEATHER, D.S. - 1846 (HEMLOCK 7°-N52°W- 12 LINKS) (HEMLOCK 7°-S60°E-6 LINKS)
 M.S. McNABB - 1918 - ID COR POSITION BY WOOD STAKE FROM SEC SUBDIVISION SURVEY OF SEC 3 BY F.J. MERRIAM YEARS AGO

B. Description of corner evidence found and/or method applied in restoring or reestablishing corner:

- G-2 [W1/4 COR SEC 3] FOUND, AT FENCE LINE NORTH AND 30' BELOW EXISTING ROAD SURFACE AND IRON PIN, ACCEPTED THIS CORNER MONUMENT AS BEING THE ONE SET BY McNABB IN 1944 AND AS BEING A CAREFUL & FAITHFUL REESTABLISHMENT OF THE POSITION OF THE ORIGINAL CORNER.
- I-2 [W1/4 COR OF SEC 2] FOUND IRON PIN IN PLACE, ID CORNER POSITION FROM THE SUPERVISOR'S PLAT OF THE VILLAGE OF KIPLING AS REC'D. IN LIBER "B" OF PLATS ON PAGE 39.

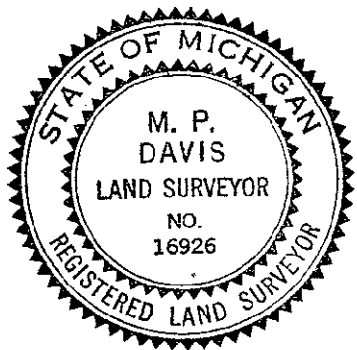

C. Description of monument for corner and accessories established to perpetuate locating the position of the corner:

- G-2 SET, OVER EXISTING MON A 5/8" X 18" REBAR W/A 3-1/4" ALUM CAP STAMPED TO ID COR POSITION & RAISED TO RD SURFACE W/A MON BOX
 POWER POLE W. BIRCH 12" SURVEY MONUMENT SIGN POST NOTE: OPEN FARM FIELDS SURROUND THIS AREA NO OTHER WIT'S NEAR
 N69°E S.20°E NORTH
 66.46' (TO FACE) 67.93' 21.45' (TO FACE)
- I-2 REPLACED EXISTING MON W/A 4" X 4" X 36" CONC MON W/A BRASS CAP STAMPED TO ID THE COR POSITION
 RED PINE 13' NW COR GARAGE SURVEY MONUMENT SIGN POST NOTE: IN E-W FENCE LINE
 S14°E S40°W N45°E
 12.33' 44.85' 0.90' (TO FACE)

NOTE: BEARINGS TO REFERENCE OBJECTS ARE MAGNETIC & DISTANCES ARE TO A NAIL IN THE CENTER OF THE OBJECT UNLESS OTHERWISE NOTED

Signed by M.P. Davis Date 11/15/93
 Surveyor's Michigan License No. 16926