

FEB 18 1994

COMMISSION

Approved By Delta County Land Survey Remonumentation Peer Group Under Act 345 Of P.A. Of 1990 On Jan 20, 1994
Robert Schmalz
Acting Chairman

LAND CORNER RECORDATION CERTIFICATE
Filing Requirement of Act 74, Mich. P.A. 1970

For corners in

DELTA (County)	Located In:	Corner Code #
1. Public Land Survey	T <u>40 N</u> R <u>22 W</u>	<u>C-2</u> (I-1)
	T _____ R _____	_____
	T _____ R _____	_____
	T _____ R _____	_____
2. Property Controlling in Section	S _____ T _____ R _____	_____
	S _____ T _____ R _____	_____
3. Miscellaneous Property in Sec.	S _____ T _____ R _____	_____
	S _____ T _____ R _____	_____

Recorded January 21, 1994
at 9:00 o'clock a.m. in Liber 7 Page 351
Walter C. Thum Reg. of Deeds.
Delta County, Michigan
Register of Deeds Stamp & File Number

- 4. Lot No. _____, Recorded Plat _____
- 5. Private Claims
[C-2] W1/4 COR SEC 5 [I-1] NW COR SEC 2]

	A	B	C	D	E	F	G	H	I	J	K	L	M
2	6	5	4	3	2	1							
3													
4	7	8	9	10	11	12							
5													
6	13	17	16	15	14	13							
7													
8	19	20	21	22	23	24							
9													
10	30	29	28	27	26	25							
11													
12	31	32	33	34	35	36							
13													

I, M.P. DAVIS, in a field survey on NOVEMBER, 1993, do hereby certify that under requirements of P.A. 74, Michigan P.A. of 1970, the corner points mentioned in lines 1 and 2 above were in conformance with regulations and rules therefore as required in the current manual of survey instructions of the United States Department of the Interior, Bureau of Land Management or by a decree of a Court of Law and/or that the corner points mentioned in lines 3, 4 and 5 above were in conformance with the rules of the Michigan Board of Land Surveyors or by a Decree of a Court of Law; established, re-established, monumented, re-monumented, recovered, found as expressed below:


NOTE: Not more than 4 corners, all in the same town and range, may be recorded on this certificate.

A. Description of original monument and accessories and/or subsequent restoration:

- C-2 [W1/4 COR SEC 5] WOOD POST - A. MERRYWEATHER, D.S. - 1846 (SOFT MAPLE 7"-S10°E-68 LINKS) (HEMLOCK 22"-N20°W-5 LINKS) M.S. McNABB - 1932 - ID CORNER POSITION BY I.P FOUND IN PLACE-NEW BT'S NOTED SOFT MAPLE 7"-S47°W-41.3' & COR FENCE POST N50°W-25.2'
- I-1 [NW COR SEC 2] WOOD POST - A. MERRYWEATHER, D.S. - 1846 (SOFT MAPLE 10"-S40°E-12 LINKS) (CEDAR 12"-S43°W-30 LINKS) M.S. McNABB - 1917 - ID CORNER POSITION FROM ORIGINAL CEDAR BT (DOWN-SCRIBE MARKS STILL PLAIN) SET NEW STAKE & BT'S DOUBLE POPLAR STUMP S45°E-19.8' & ASH 4"-S50°W-36.8' M.D.O.T. (DATE UNKNOWN) FOUND SQ'D CEDAR POST IN PLACE - BT'S NOTED (ASH 5" S50°W-6.5') (POPLAR 12"-NORTH-23.0') (CEDAR 4"-S74°E-8.25)

B. Description of corner evidence found and/or method applied in restoring or reestablishing corner:

- C-2 [W1/4 COR SEC 5] FOUND 1-1/4" I.P. IN EAST-WEST COUNTY ROAD 9' NORTH OF C.L. FROM WHICH A MAPLE (NOW 17") BEARS S47°W-41.3'-McNABB'S DISTANCE TO C.L. OF HWY M-35 ALSO CHECKS WELL FROM THIS MONUMENT. ACCEPTED EXISTING MONUMENT AS BEING A CAREFUL & FAITHFUL REESTABLISHMENT OF THE POSITION OF THE ORIGINAL CORNER.
- I-1 [NW COR SEC 2] FOUND 5/8" REBAR IN CENTER LINE MEDIAN OF HWY. U.S. 2 & 41, ID CORNER POSITION FROM M.D.O.T. CONSTRUCTION PLANS FOR HWY U.S. 2 & 41 - ACCEPTED SAME AS BEING A CAREFUL AND FAITHFUL PERPETUATION OF THE POSITION OF THE ORIGINAL CORNER.

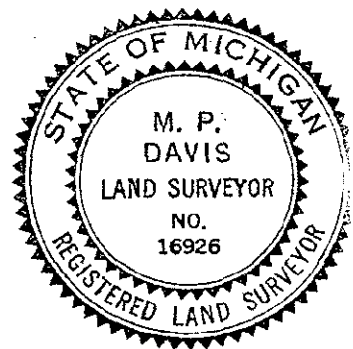

C. Description of monument for corner and accessories established to perpetuate locating the position of the corner:

- C-2 SET INSIDE EXISTING I.P. A 5/8" X 1/8" REBAR W/A 3-1/4' ALUM CAP STAMPED TO ID COR POSITION & RAISED TO RD SURFACE W/A MON BOX
POWER POLE MAPLE 17" ANCHOR POLE MAPLE 17"
N39°W N46°E S9°W S47°W
30.13' 73.16' 39.22' 41.3'
- I-1 SET 3-1/4" ALUMN CAP STAMPED TO ID COR POSITION OVER REBAR & RAISED TO GROUND LEVEL W/A MON BOX NO WIT'S NEAR AS COR POSITION IS LOCATED IN C.L. MEDIAN OF 4 LANE HWY (U.S. 2 & 41)
SURVEY MON SIGN POST - N33°E-2.54' (TO FACE)
CORNER POSITION IS LOCATED AT HWY STA 842+83.5

NOTE: BEARINGS TO REFERENCE OBJECTS ARE MAGNETIC & DISTANCES ARE TO A NAIL IN THE CENTER OF THE OBJECT UNLESS OTHERWISE NOTED

Signed by M.P. Davis Date 12/30/93

Surveyor's Michigan License No. 16926