

SURVEY & REMONUMENTATION

OCT 03 2000

SECTION

LAND CORNER RECORDATION CERTIFICATE
 Filing Requirement of Act 74, Mich. P.A. 1970

Approved By Delta County
 Land Survey Remonumentation
 Peer Group Under Act 345 of
 P.A. Of 1990 On July 12, 2000
Walter C. Thomas
 Acting Chairman

For corners in

<u>DELTA</u> (County)	Located In:	Corner Code #
1. Public Land Survey	T40 N R 23 W	✓ A-03 SAME
	T40 N R 24 W	M-03 CORNER
	T40 N R 23 W	A-04 SAME
	T40 N R 24 W	M-04 CORNER
2. Property Controlling in Section	S ___ T ___ R ___	___
3. Miscellaneous Property in Sec.	S ___ T ___ R ___	___
	S ___ T ___ R ___	___


A-03 [NW COR SEC 7] A-04 [W1/4 COR SEC 7]

RECORDED 28 July 2000
 AT 9:00 O'CLOCK a.m.
 LIBER 9 PAGE 238
Walter C. Thomas
 DELTA COUNTY MI REG. OF DEEDS
 Register of Deeds Stamp & File Number

4. Lot No. _____, Recorded Plat _____
 5. Private Claims _____

I, M.P. DAVIS, in a field survey on JUNE, 00 do hereby state that under requirements of P.A. 74, Michigan P.A. of 1970, the corner points mentioned in lines 1 and 2 above were in conformance with regulations and rules therefore as required in the current manual of survey instructions of the United States Department of the Interior, Bureau of Land Management or by a decree of a Court of Law and /or that the corner points mentioned in lines 3, 4 and 5 above were in conformance with the rules of the Michigan Board of Land Surveyors or by a Decree of a Court of Law, established, re-established, monumented, recovered, found as expressed below:

NOTE: Not more than 2 corners, all in the same town and range, may be recorded on this certificate.

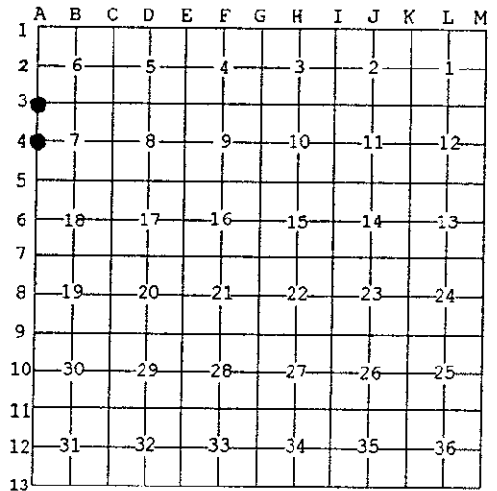

A. Description of original monument and accessories and/or subsequent restoration:

A-03 [NW COR SEC 7] JOHN BURT, D.S.-1845-WOOD POST-(CEDAR 12 S54°W 53 LINKS)(SPRUCE 09" N70°W 33 LINKS)
 A.MERRYEATHER, D.S.-1846-(CEDAR 10" N40°E 16 LINKS)(CEDAR 08" S58°E 07 LINKS)
 M.S.McNABB-1914-ID FROM ORIGINALS BT'S NW & SW & NOTE4D NEW BT'S (CEDAR 3" S20°E 10.5)(CEDAR 5" N63°W 8.0')

A-04 [W1/4 COR SEC 7] JOHN BURT, D.S.-1845- WOOD POST (HEMLOCK 06" S12°W NO DIST GIVEN)(HEMLOCK 08" N30°W 07 LINKS)
 M.S.McNABB-1936-ORIGINALS GONE- SET STAKE "1/2 DISTANCE" BETWEEN CORNERS (CEDAR STUMP 22" S5°E 20.75')

B. Description of corner evidence found and/or method applied in restoring or reestablishing corner:

A-03 [NW COR SEC 7] FOUND IN PLACE AND BURIED IN THE MUCK THE REMAINS OF A POST POINT. ID CORNER MONUMENT BY EXTENDING A LINE NORTH FROM THE SW COR OF SEC 7 & THRU THE W1/4 COR OF SEC 7 AND CONDUCTING OUR SEARCH IN THE COMPUTED POSITION BASED UPON McNABB'S 1936 SURVEY OF THE WEST LINE OF SEC 7. TWO CEDAR STUMP MOUNDS EXIST TO THE SE & SW WHICH MATCH WELL WITH THE "GLO" BEARING & DISTANCE BUT ARE ONLY IDENTIFIABLE BY THEIR RELATIONSHIP TO THE MONUMENT FOUND. ACCEPTED EXISTING MONUMENT AS BEING A CAREFUL & FAITHFUL PERPETUATION OF THE POSITION OF THE ORIGINAL CORNER.

A-04 [W1/4 COR SEC 7] FOUND REMAINS OF A WOOD POST, ID AS THE SAME AS THAT SET BY McNABB IN 1936 FROM HIS CEDAR STUMP BT WHICH IS STILL IN PLACE WITH SCRIBE MARKS PLAIN. ACCEPTED EXISTING MONUMENT AS BEING A CAREFUL & FAITHFUL REESTABLISHMENT OF THE CORNER POSITION.



C. Description of monument for corner and accessories established to perpetuate locating the position of the corner:

A-03 REPLACED POST POINT W/A BERNTSEN A1N830 ALUM MONUMENT WITH THE CAP STAMPED TO ID THE CORNER POSITION.

CEDAR 06"	CEDAR 08"	CEDAR 09"	CEDAR 10"	SURVEY MONUMENT SIGN POST
N52°W	N34°E	S39°E	S63°W	EAST
25.84'	18.80'	23.39'	31.73'	0.76' (TO FACE)

A-04 REPLACED POST POINT W/A BERNTSEN A1N830 ALUM MONUMENT WITH THE CAP STAMPED TO ID THE CORNER POSITION.

SPRUCE 10"	SPRUCE 07"	CEDAR 11"	BALSAM 06"	SURVEY MONUMENT SIGN POST
N20°W	N75°E	S07°E	S67°W	SOUTH
37.25'	12.37'	17.67'	08.15'	1.70' (TO FACE)

NOTE: BEARINGS TO REFERENCE OBJECTS ARE MAGNETIC-DISTANCES ARE TO A NAIL W/A DELTA COUNTY REFERECNE TAG, UNLESS OTHERWISE NOTED.

Signed by M.P. Davis Date 7/13/00
 Surveyor's Michigan License No. 16926