

SURVEY & REMONUMENTATION

OCT 03 2000

SECTION

LAND CORNER RECORDATION CERTIFICATE
Filing Requirement of Act 74, Mich. P.A. 1970

Approved By Delta County
Land Survey Remonumentation
Peer Group Under Act 345 of

P.A. Of 1990 On July 12, 2000

Shirley A. Hameling
Acting Chairman

For corners in

<u>DELTA</u> (County)	Located In:	Corner Code #
1. Public Land Survey	T ⁴⁰ N R ²³ W	B-08 ✓
	T ⁴⁰ N R ²³ W	B-10
	T _____ R _____	_____
	T _____ R _____	_____
2. Property Controlling in Section	S _____ T _____ R _____	_____
	S _____ T _____ R _____	_____
3. Miscellaneous Property in Sec.	S _____ T _____ R _____	_____
	S _____ T _____ R _____	_____

B-08 [C1/4 COR SEC 19] B-10 [C1/4 COR SEC 30]

RECORDED 28 July 2000

AT 9:00 O'CLOCK a.m.

LIBER 9 PAGE 220

William C. Thomas
DELTA COUNTY MI REG. OF DEEDS

Register of Deeds Stamp & File Number

4. Lot No. _____, Recorded Plat _____
5. Private Claims _____

I, M.P. DAVIS, in a field survey on MAY, 00 do hereby state that under requirements of P.A. 74, Michigan P.A. of 1970, the corner points mentioned in lines 1 and 2 above were in conformance with regulations and rules therefore as required in the current manual of survey instructions of the United States Department of the Interior, Bureau of Land Management or by a decree of a Court of Law and /or that the corner points mentioned in lines 3, 4 and 5 above were in conformance with the rules of the Michigan Board of Land Surveyors or by a Decree of a Court of Law; established, re-established, monumented, recovered, found as expressed below:

NOTE: Not more than 2 corners, all in the same town and range, may be recorded on this certificate.


A	B	C	D	E	F	G	H	I	J	K	L	M
1												
2	6	5	4	3	2	1						
3												
4	7	8	9	10	11	12						
5												
6	10	17	16	15	14	13						
7												
8	18	20	21	22	23	24						
9												
10	19	29	28	27	26	25						
11												
12	31	32	33	34	35	36						
13												

A. Description of original monument and accessories and/or subsequent restoration:

- B-08 [C1/4 COR SEC 19] NOT SET IN ORIGINALS
M.S.McNABB-1921-ESTABLISHED AT INTERSECTION OF 1/4 LINES-SET OLD SHOTGUN BARREL-CEDAR STUMP S20°W 7.7'
- B-10 [C1/4 COR SEC 30] NOT SET IN ORIGINALS
M.S.McNABB-1924-SET AT INTERSECTION OF 1/4 LINES-IRON STAKE IN ROAD-BT STAKES NORTH & SOUTH 20'
M.S.McNABB-1925-IRON BOLT IN PLACE SET PREVIOUS-BT STAKES NORTH & SOUTH 20'

B. Description of corner evidence found and/or method applied in restoring or reestablishing corner:

- B-08 [C1/4 COR SEC 19] FOUND IN PLACE McNABB'S SHOTGUN BARREL AT THE JCT OF ANCIENT FENCE LINES E-W & S. McNABB'S CEDAR STUMP BT IS NOW DOWN AND OUT OF THE GROUND. POSITIONAL ACCURACY OF THE EXISTING MONUMENT WELL WITHIN ACCEPTABLE LIMITS FOR THE TIME PERIOD OF ITS ESTABLISHMENT. ACCEPTED EXISTING MONUMENT AS BEING A CAREFUL & FAITHFUL ESTABLISHMENT OF THE CORNER POSITION.
- B-10 [C1/4 COR SEC 30] FOUND IN PLACE & 32"± BELOW THE ROAD SURFACE AN IRON BOLT. NO EVIDENCE OF McNABB'S BT POST. POSITIONAL ACCURACY OF THE EXISTING MONUMENT WELL WITHIN THE ACCEPTABLE LIMITS FOR THE TIME PERIOD OF ITS ESTABLISHMENT. ACCEPTED EXISTING MONUMENT AS BEING A CAREFUL & FAITHFUL ESTABLISHMENT OF THE CORNER POSITION.

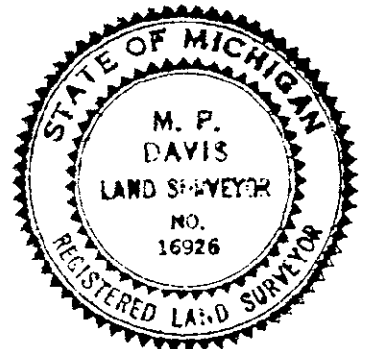

C. Description of monument for corner and accessories established to perpetuate locating the position of the corner:

- B-08 SET OVER EXISTING MONUMENT A BERNTSEN A1NB30 ALUM MONUMENT WITH THE CAP STAMPED TO ID THE CORNER POSITION.
W.BIRCH 06" TAMARACK 05" TAMARACK 09" TAMARACK 07" SURVEY MONUMENT SIGN POST
S16°E N46°W N22°E N87°E S55°W
40.35' 25.79' 37.59' 32.70' 1.63' (TO FACE)
- B-10 SET OVER EXISTING MON A 5/8" X 18" REBAR W/A3-1/4" ALUM CAP STAMPED TO ID THE COR POSITION & RAISED TO GRADE W/A MON BOX
DRILL HOLES IN FIELD STONES 5/8" X 18" REBARS W/A ALUM WITNESS CAP SURVEY MONUMENT SIGN POST
N56°W N73°E S45°E S45°W SOUTH
51.85' 37.67' 27.56' 22.63' 29.28' (TO FACE)

NOTE: BEARINGS TO REFERENCE OBJECTS ARE MAGNETIC-DISTANCES ARE TO A NAIL W/A DELTA COUNTY REFERECNE TAG, UNLESS OTHERWISE NOTED.

Signed by M.P. Davis
Surveyor's Michigan License No. 16926

Date 7/13/00