

SURVEY & REMONUMENTATION

OCT 26 1995

COMMISSION

Approved by Delta County
Land Survey Remonumentation
Peer Group Under Act 345 Of
P.A. Of 1990 On June 6, 1995
[Signature]
Acting Chairman

LAND CORNER RECORDATION CERTIFICATE
Filing Requirement of Act 74, Mich. P.A. 1970

For corners in DELTA (County)
Located In: _____ Corner Code #

1. Public Land Survey T 40 N R R23 W C-5 & C-6
T _____ R _____
T _____ R _____
T _____ R _____

2. Property Controlling S _____ T _____ R _____
in Section S _____ T _____ R _____

3. Miscellaneous S _____ T _____ R _____
Property in Sec. S _____ T _____ R _____

Recorded JUN 13 1995
at 9:00 o'clock A.M. in Liber 8 Page 72
[Signature] Reg. of Deeds.
Delta County, Michigan
Register of Deeds Stamp & File Number

4. Lot No. _____, Recorded Plat _____
5. Private Claims C-5 [NW COR SEC 17] C-6 [W1/4 COR SEC 17]

	A	B	C	D	E	F	G	H	I	J	K	L	M
2	6		5		4		3		2		1		
3													
4	7		8		9		10		11		12		
5													
6	18		17		16		15		14		13		
7													
8	19		20		21		22		23		24		
9													
10	30		29		28		27		26		25		
11													
12	31		32		33		34		35		36		
13													

M.P. DAVIS, in a field survey on MAY, 1995, do hereby certify that under requirements of P.A. 74, Michigan P.A. of 1970, the corner points mentioned in lines 1 and 2 above were in conformance with regulations and rules therefore as required in the current manual of survey instructions of the United States Department of the Interior, Bureau of Land Management; or by a decree of a Court of Law and/or that the corner points mentioned in lines 3, 4 and 5 above were in conformance with the rules of the Michigan Board of Land Surveyors or by a Decree of a Court of Law; established, re-established, monumented, re-monumented, recovered, found as expressed below:


NOTE: Not more than 4 corners, all in the same town and range, may be recorded on this certificate.

A. Description of original monument and accessories and/or subsequent restoration:

- C-5 [NW COR SEC 17] WOOD POST - A. MERRYWEATHER, D.S. - 1846 (BURNT CEDAR 10'-N15'E-13 LINKS) (BURNT CEDAR 08'-S59'E-58 LINKS) M.S. M.S. McNABB - 1913 - "NO ORIGINALS FOUND" ID CORNER POSITION BY WOOD STAKE IN HWY. & PROPERTY LINES-SET BY STAKES NW & SE 33'
- C-6 [W1/4 COR SEC 17] WOOD POST - A. MERRYWEATHER, D.S. - 1846 (BURNT CEDAR 10'-N15'E-13 LINKS) (BURNT CEDAR 08'-S08'W-16 LINKS) M.S. McNABB - 1917 - ID CORNER POSITION BY IRON STAKE IN HWY. SET "1/2 DISTANCE BETWEEN CORNERS."

B. Description of corner evidence found and/or method applied in restoring or reestablishing corner:

- C-5 [NW COR SEC 17] NO EVIDENCE OF McNABB'S 1913 STAKE OR BT STAKES FOUND. ID SW & W1/4 COR'S OF SEC 17 & EXTENDED LINE NORTH FROM SW COR THRU W1/4 COR AND RESET SEC COR ON THIS LINE AND AT PROPORTIONATE DISTANCE NORTH OF W1/4 COR. ACCEPTED THIS POSITION AS BEING THE BEST AVAILABLE EVIDENCE AS TO OF THE POSITION OF THE ORIGINAL CORNER.
- C-6 [W1/4 COR SEC 17] FOUND, IN PLACE & 22' BELOW COUNTY ROAD SURFACE, McNABB'S 1917 IRON PIN. IDENTIFIED SAME BY COMPARISON OF McNABB'S MEASUREMENT SOUTH TO THE SEC CORNER. ACCEPTED EXISTING MONUMENT AS BEING A CAREFUL & FAITHFUL REESTABLISHMENT OF THE POSITION OF THE ORIGINAL CORNER.

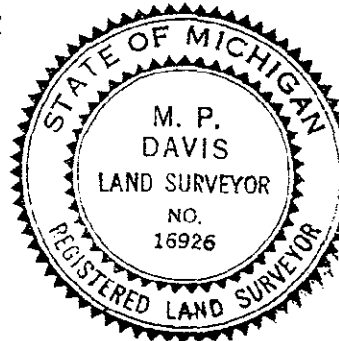

C. Description of monument for corner and accessories established to perpetuate locating the position of the corner:

- C-5 SET BERNTSEN ALINB30 ALUMN MONUMENT WITH THE CAP STAMPED TO ID THE CORNER POSITION.
MAPLE 24" POWER POLE SURVEY MONUMENT SIGN POST
S23'E S35'W EAST
68.90' 43.93' (TO FACE) 2.49' (TO FACE)
- C-6 SET, OVER EXISTING MON, A 5/8" X 18" REBAR W/A 3-1/4" ALUM CAP STAMPED TO ID COR POSITION & RAISED TO RD SURFACE W/A MON BOX SURVEY MONUMENT SIGN POST WEST NOTE: ALL FOUR QUADRANTS OCCUPIED BY CULTIVATED FARM FIELDS - NO WIT'S AVAILABLE.
31.28' (TO FACE)

NOTE: BEARINGS TO REFERENCE OBJECTS ARE MAGNETIC & DISTANCES ARE TO A NAIL IN THE CENTER OF THE OBJECT UNLESS OTHERWISE NOTED

Signed by M.P. Davis Date 6/3/95
Surveyor's Michigan License No. 16926