

FEB 18 1994

COMMISSION

Approved By Delta County Land Survey Remonumentation Peer Group Under Act 345 Of P.A. Of 1990 On Jan. 20, 1994
Robert Behmeling
Acting Chairman

LAND CORNER RECORDATION CERTIFICATE
Filing Requirement of Act 74, Mich. P.A. 1970

For corners in DELTA
(County)

Located In: Corner Code 44

- 1. Public Land Survey T 40 N R 23 W C-3 & C-7
T _____ R _____
T _____ R _____
T _____ R _____
- 2. Property Controlling S _____ T _____ R _____
in Section S _____ T _____ R _____
- 3. Miscellaneous S _____ T _____ R _____
Property in Sec. S _____ T _____ R _____

Recorded January 21, 1994
at 9:00 clock a.m. Liber 7 page 378
William A. Brown Reg. of Deeds
Delta County, Michigan
Register of Deeds Stamp & File Number

- 4. Lot No. _____, Recorded Plat _____
- 5. Private Claims C-3 [NW COR SEC 8] C-7 [NW COR SEC 20]


I, M.P. DAVIS, in a field survey on JULY, 19 93, do hereby certify that under requirements of P.A. 74, Michigan P.A. of 1970, the corner points mentioned in lines 1 and 2 above were in conformance with regulations and rules therefore as required in the current manual of survey instructions of the United States Department of the Interior, Bureau of Land Management or by a decree of a Court of Law and/or that the corner points mentioned in lines 3, 4 and 5 above were in conformance with the rules of the Michigan Board of Land Surveyors or by a Decree of a Court of Law; established, re-established, monumented, re-monumented, recovered, found as expressed below:

NOTE: Not more than 4 corners, all in the same town and range, may be recorded on this certificate.

	A	B	C	D	E	F	G	H	I	J	K	L	M
2	6		5		4		3		2		1		
3			•										
4	7		8		9		10		11		12		
5													
6	18		17		16		15		14		13		
7			•										
8	19		20		21		22		23		24		
9													
10	30		29		28		27		26		25		
11													
12	31		32		33		34		35		36		
13													

- A. Description of original monument and accessories and/or subsequent restoration:
C-3 [NW COR SEC 8] WOOD POST - A. MERRYWEATHER, D.S. - 1846 (BEECH 14'-N56°E-11 LINKS) (BEECH 10'-S60°W-26 LINKS)
M.S. McNABB - 1919 - ID CORNER FROM "GLO" SW BEECH - SET STAKE & NOTED NEW BT (MAPLE 4'-S18°W-15.8')
- C-7 [NW COR SEC 20] WOOD POST - A. MERRYWEATHER, D.S. - 1846 (BURNT CEDAR 5'-N85°W-15 LINKS) (BURNT BIRCH 7'-S14°W-S43°E-20 LINKS)
M.S. McNABB - 1914 - ID CORNER POSITION BY STAKE IN HWY. & BT STAKES NW & SE 33' - SET IRON PIPE
M.S. McNABB - 1921 - IRON PIPE SET PREVIOUS - REFERENCE MONUMENT NW 33'

- B. Description of corner evidence found and/or method applied in restoring or reestablishing corner:
C-3 [NW COR SEC 8] NO EVIDENCE OF McNABB'S 1919 STAKE OR BT FOUND, AREA HAS BEEN GREATLY DISRUPTED BY FARMING OPERATIONS - FOUND N1/4 COR SEC 7 & McNABB'S 1919 E1/16 (CEDAR STAKE SCRIBED "1/8") EXTENDED LINE EAST FROM N1/4 COR TERU E1/16 COR AND RESET SEC COR ON THIS LINE AND AT PROPORTIONATE DISTANCE EAST OF E1/16 COR. ACCEPTED THIS POSITION AS BEING A CAREFUL & FAITHFUL PERPETUATION OF THE POSITION OF THE ORIGINAL CORNER.
C-7 [NW COR SEC 20] FOUND, IN PLACE & 24" BELOW COUNTY ROAD SURFACE, McNABB'S 1914 IRON PIPE. IDENTIFIED SAME BY COMPARISON OF McNABB'S MEASUREMENTS TO CORNERS N, S & W ACCEPTED EXISTING MONUMENT AS BEING A CAREFUL & FAITHFUL REESTABLISHMENT OF THE POSITION OF THE ORIGINAL CORNER.

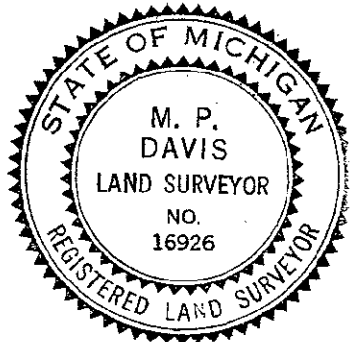

- C. Description of monument for corner and accessories established to perpetuate locating the position of the corner:
C-3 SET BERNTSEN ALNB30 ALUMN MONUMENT WITH THE CAP STAMPED TO ID THE CORNER POSITION.
MAPLE 24" TWIN MAPLE 15" SURVEY MONUMENT SIGN POST
S87°E S12°E SOUTH
44.90' 97.92' 3.69' (TO FACE)
- C-7 SET, OVER EXISTING MON, A 5/8" X 18" REBAR W/A 3-1/4" ALUM CAP STAMPED TO ID COR POSITION & RAISED TO RD SURFACE W/A MON BOX
CEDAR 5" CEDAR 5" POWER POLE SURVEY MONUMENT SIGN POST
N48°E S45°E S54°W WEST
56.14' 60.00' 39.05' (TO FACE) 20.72' (TO FACE)

NOTE: BEARINGS TO REFERENCE OBJECTS ARE MAGNETIC & DISTANCES ARE TO A NAIL IN THE CENTER OF THE OBJECT UNLESS OTHERWISE NOTED

Signed by M.P. Davis Date 12/29/93

Surveyor's Michigan License No. 16926