

SURVEY & REMONUMENTATION

FEB 18 1994

COMMISSION

LAND CORNER RECORDATION CERTIFICATE
Filing Requirement of Act 74, Mich. P.A. 1970

Approved By Delta County
Land Survey Remonumentation
Peer Group Under Act 345 Of
P.A. Of 1990 On Jan. 20, 1994

Robert Schueling
Acting Chairman

For corners in

DELTA
(County)

Located In:

Corner Code ##

1. Public Land Survey	T	40 N R	23 W	E-3 & E-9
	T	R		
	T	R		
	T	R		
2. Property Controlling in Section	S	T	R	
	S	T	R	
3. Miscellaneous Property in Sec.	S	T	R	
	S	T	R	

Recorded January 21, 1994

9:00 o'clock a.m. in Liber 7 Page 375

William C. Thomas Reg. of Deeds.
Delta County, Michigan

Register of Deeds Stamp & File Number

4. Lot No. _____, Recorded Plat _____
5. Private Claims _____
E-3 [NW COR SEC 9] E-9 [NW COR SEC 28]

A	B	C	D	E	F	G	H	I	J	K	L	M
2	6	5	4	3	2	1						
3												
4	7	8	9	10	11	12						
5												
6	13	17	16	15	14	13						
7												
8	19	20	21	22	23	24						
9												
10	30	29	28	27	26	25						
11												
12	31	32	33	34	35	36						
13												

I, M.P. DAVIS, in a field survey on JULY, 19 93, do hereby certify that under requirements of P.A. 74, Michigan P.A. of 1970, the corner points mentioned in lines 1 and 2 above were in conformance with regulations and rules therefore as required in the current manual of survey instructions of the United States Department of the Interior, Bureau of Land Management or by a decree of a Court of Law and/or that the corner points mentioned in lines 3, 4 and 5 above were in conformance with the rules of the Michigan Board of Land Surveyors or by a Decree of a Court of Law; established, re-established, monumented, re-monumented, recovered, found as expressed below:

NOTE: Not more than 4 corners, all in the same town and range, may be recorded on this certificate.

A. Description of original monument and accessories and/or subsequent restoration:


E-3 [NW COR SEC 9] WOOD POST - A. MERYWEATHER, D.S. - 1846 (BEECH 14'-N56°E-11 LINKS) (BEECH 10'-S60°W-26 LINKS)
M.S. McNABB - 1914 - ID CORNER POSITION BY FENCE CORNER SAID BY SETTLERS TO HAVE BEEN PLACED WHERE ORIGINAL CORNER STOOD-SET SET WOOD STAKE AT FENCE CORNER - NO WIT'S NOTED

E-9 [NW COR SEC 28] WOOD POST - A. MERRYWEATHER, D.S. - 1846 (BEECH 12'-N70°W-18 LINKS) (BEECH 20'-N58°E-18 LINKS)
D.A. BROTHERTON - 1895 - WOOD POST IN ROCK PILE - IDENTIFIED PREVIOUSLY FROM "GLO" BEECH
SW COR LOG HOUSE N36°30'E-87.4' - CEDAR FENCE POST - WEST - 24.9'
M.S. McNABB - 1920 - PD BLADE OF SCYTH IN HWY, SET IRON STAKE - CORNER FENCE POSTS NWLY-35.3' SELY-36.5' SWLY-35'

B. Description of corner evidence found and/or method applied in restoring or reestablishing corner:

E-3 [NW COR SEC 9] FOUND REMAINS OF WOOD POST AT JCT. OF FENCE LINES E-W & S - COR POSITION WAS SHOWN TO ME BY LOWELL STEFF A LONG TIME PROPERTY OWNER WHO STATED THAT SQ'D WOOD STAKE STOOD AT THE JCT OF THE FENCE LINES FOR MANY YEARS. ACCEPTED THIS MONUMENT AS BEING A CAREFUL AND FAITHFUL PERPETUATION OF THE POSITION OF THE ORIGINAL CORNER.

E-9 [NW COR SEC 28] FOUND IRON PIN 24" BELOW ROAD SURFACE, IDENTIFIED THIS MONUMENT AS BEING THAT SET BY McNABB IN 1920 BY COMPARISON OF HIS DISTANCES TO ADJOINING CORNERS. ACCEPTED THIS MONUMENT AS BEING A CAREFUL & FAITHFUL PERPETUATION OF THE POSITION OF THE ORIGINAL COR.

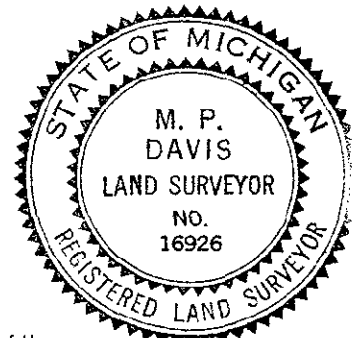

C. Description of monument for corner and accessories established to perpetuate locating the position of the corner:

E-3 REPLACED WOOD POST W/A 4" X 4" X 36" CONCRETE MONUMENT W/A BRASS CAP STAMPED TO ID THE CORNER POSITION
MAPLE 10" MAPLE 10" MAPLE 12" SURVEY MONUMENT SIGN POST
S53°W S46°E S14°W SOUTH
64.63' 38.83' 68.22' 2.25' (TO FACE)

E-9 SET, OVER EXISTING MON, A 5/8" X 18" REBAR W/A 3-1/4" ALUM CAP STAMPED TO ID THE COR POSITION & RAISED TO RD SURFACE W/A MON BC
POWER POLE DRILL HOLE IN FIELD STONE DRILL HOLE IN FIELD STONE SURVEY MONUMENT SIGN POST
N42°W N41°E S24°E S25°W
41.45' (TO FACE) 35.30' 58.20' 57.95' (TO FACE)

NOTE: BEARINGS TO REFERENCE OBJECTS ARE MAGNETIC & DISTANCES ARE TO A NAIL IN THE CENTER OF THE OBJECT UNLESS OTHERWISE NOTED

Signed by M.P. Davis Date 12/29/93

Surveyor's Michigan License No. 16926

LIBER 7 PAGE 375