

SURVEY & REMONUMENTATION

OCT 26 1995

COMMISSION

Approved by Delta County
Land Survey Remonumentation
Peer Group Under Act 345 Of

P.A. Of 1990 On June 6, 1995

LAND CORNER RECORDATION CERTIFICATE

Filing Requirement of Act 74, Mich. P.A. 1970

Robert A. Schmelz
Chairman

For corners in

DELTA

(County)

Located In:


Corner Code #

- 1. Public Land Survey T 40 N R 23 W
- T _____ R _____
- T _____ R _____
- T _____ R _____
- 2. Property Controlling S _____ T _____ R _____
- in Section S _____ T _____ R _____
- 3. Miscellaneous S _____ T _____ R _____
- Property in Sec. S _____ T _____ R _____

E-4	&	E-5

Recorded Jan 13 1995
at 9:00 o'clock A.M. in Liber 8 Page 77
William C. Thomas Reg. of Deeds.
Delta County, Michigan
Register of Deeds Stamp & File Number

- 4. Lot No. _____, Recorded Plat _____
- 5. Private Claims _____
E-4 [W1/4 COR SEC 9] E-5 [NW COR SEC 16]

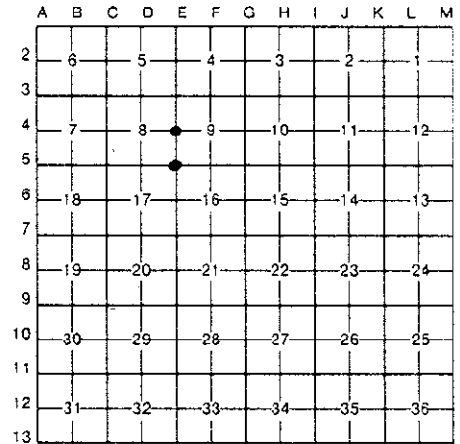

I, M.P. DAVIS, in a field survey on JULY, 1993, do hereby certify that under requirements of P.A. 74, Michigan P.A. of 1970, the corner points mentioned in lines 1 and 2 above were in conformance with regulations and rules therefore as required in the current manual of survey instructions of the United States Department of the Interior, Bureau of Land Management or by a decree of a Court of Law and/or that the corner points mentioned in lines 3, 4 and 5 above were in conformance with the rules of the Michigan Board of Land Surveyors or by a Decree of a Court of Law; established, re-established, monumented, re-monumented, recovered, found as expressed below:


NOTE: Not more than 4 corners, all in the same town and range, may be recorded on this certificate.

A. Description of original monument and accessories and/or subsequent restoration:

- E-4 [W1/4 COR SEC 9] WOOD POST - A.MERRYWEATHER, D.S. - 1846 (MAPLE 18"-S67°W-20 LINKS) (MAPLE 28"-N45°E-46 LINKS)
M.S. McNABB - 1918 - ID COR POSITION FROM EXISTING WOOD STAKE & IRON IN PLACE & MAPLE 16" BT S33°E-32'
- E-5 [NW COR SEC 16] WOOD POST - A.MERRYWEATHER, D.S. - 1846 (BURNT TAMERAC 8"-N40°E-12 LINKS) (BURNT TAMERAC 9"-S75°W-6 LINKS)
M.S. McNABB - 1918 - ID COR POSITION FROM EXISTING WOOD STAKE & CEDAR 5" BT N65°E-26.3'

B. Description of corner evidence found and/or method applied in restoring or reestablishing corner:

- E-4 [W1/4 COR SEC 9] FOUND IN PLACE THIS DATE AN IRON BOLT AT THE APPROX CENTER LINE PI OF THE COUNTY ROAD, NO EVIDENCE OF THE MAPLE BT REMAINS. VERIFIED CORNER MONUMENT BY LINE & DISTANCE EAST TO McNABB'S 1918 CW1/16 & C1/4 CORNERS. ACCEPTED EXISTING MONUMENT AS BEING A CAREFUL & FAITHFUL REESTABLISHMENT OF THE POSITION OF THE ORIGINAL CORNER.
- E-5 [NW COR SEC 16] FOUND IN PLACE THIS DATE THE POINTED REMAINS OF A SQ'D WOOD POST AT THE JCT. OF ANCIENT FENCE LINES N-S & E-W (FENCE LINES ARE DOWN & IN POOR CONDITION) NO EVIDENCE OF McNABB'S CEDAR BT FOUND. MEASUREMENTS N & E TO ADJOINING CORNERS COMPARE WELL WITH THE RECORD DISTANCES OF McNABB. ACCEPTED EXISTING MONUMENT AS BEING A CAREFUL & FAITHFUL REESTABLISHMENT OF THE POSITION OF THE ORIGINAL CORNER.

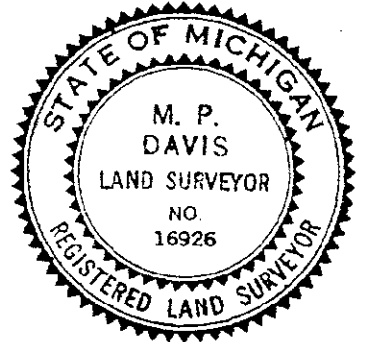

C. Description of monument for corner and accessories established to perpetuate locating the position of the corner:

- E-4 REPLACED EXISTING IRON BOLT W/A 5/8" X 18" REBAR W/A 3-1/4" ALUMN CAP STAMPED TO ID THE CORNER POSITION
POWER POLE FENCE POST SURVEY MONUMENT SIGN POST NOTE: CORNER IS IN FARM AREA
N47°E S30°W N47°W NO OTHER HIT'S AVAILABLE
31.12' (TO FACE) 18.30' 6.53' (TO FACE)
- E-5 REPLACED EXISTING MONUMENT W/A BERNTSEN ALN830 ALUMN MON WITH THE CAP STAMPED TO ID THE COR POSITION
WHITE BIRCH 7' WHITE BIRCH 10" SURVEY MONUMENT SIGN POST
N53°E S56°E S45°W
47.30' 12.45' 2.20' (TO FACE)

NOTE: BEARINGS TO REFERENCE OBJECTS ARE MAGNETIC & DISTANCES ARE TO A NAIL IN THE CENTER OF THE OBJECT UNLESS OTHERWISE NOTED

Signed by M.P. Davis
Surveyor's Michigan License No. 16926

Date 6/3/95