

SURVEY & REMONUMENTATION

OCT 03 2000

SECTION

LAND CORNER RECORDATION CERTIFICATE
Filing Requirement of Act 74, Mich. P.A. 1970

Approved By Delta County
 Land Survey Remonumentation
 Peer Group Under Act 345 of
 P.A. of 1990 On July 12, 2000
Shirley A. Hummel
 Delta County Chairman

For corners in

<u>DELTA</u> (County)	Located In:	Corner Code #
1. Public Land Survey	T <u>40</u> N R <u>23</u> W	H-03 ✓
	T <u>40</u> N R <u>23</u> W	H-05
	T _____ R _____	_____
	T _____ R _____	_____
	T _____ R _____	_____
2. Property Controlling in Section	S _____ T _____ R _____	_____
	S _____ T _____ R _____	_____
3. Miscellaneous Property in Sec.	S _____ T _____ R _____	_____
	S _____ T _____ R _____	_____

RECORDED 28 July 2000
 AT 9:00 O'CLOCK a.m.
 LIBER 9 PAGE 212
Walter C. Thomas
 DELTA COUNTY MI REG. OF DEEDS

Register of Deeds Stamp & File Number

H-03 [N1/4 COR SEC 10] H-05 [N1/4 COR SEC 15]
 4. Lot No. _____, Recorded Plat _____
 5. Private Claims _____

I, M.P. DAVIS, in a field survey on MAY, 2000 do hereby state that under requirements of P.A. 74, Michigan P.A. of 1970, the corner points mentioned in lines 1 and 2 above were in conformance with regulations and rules therefore as required in the current manual of survey instructions of the United States Department of the Interior, Bureau of Land Management or by a decree of a Court of Law and /or that the corner points mentioned in lines 3, 4 and 5 above were in conformance with the rules of the Michigan Board of Land Surveyors or by a Decree of a Court of Law; established, re-established, monumented, recovered, found as expressed below:

NOTE: Not more than 2 corners, all in the same town and range, may be recorded on this certificate.


	A	B	C	D	E	F	G	H	I	J	K	L	M
1													
2	6	5	4					3	2	1			
3								●					
4	7	8	9					10	11	12			
5								●					
6	18	17	16					15	14	13			
7													
8	19	20	21					22	23	24			
9													
10	30	29	28					27	26	25			
11													
12	31	32	33					34	35	36			
13													

A. Description of original monument and accessories and/or subsequent restoration:

- H-03 [N1/4 COR SEC 10] A. MERRYWEATHER, D.S. - 1846 - SET POST - (CEDAR 12" N35°W 16 LINKS) (CEDAR 18" S10°W 19 LINKS) NO RECORD EVIDENCE OF CORNER RECOVERY AND/OR SUBSEQUENT REMONUMENTATION
- H-05 [N1/4 COR SEC 15] A. MERRYWEATHER, D.S. 1846 - (BIRCH 12" S50°E 03 LINKS) (HEMLOCK 07" N20°E 08 LINKS) M.S. McNABB - 1927 - ORIGINALS GONE, ESTABLISHED 1/2 DISTANCE BETWEEN CORNERS - SET IRON PIPE & STAKE (W. BIRCH N37°W 10.8)

B. Description of corner evidence found and/or method applied in restoring or reestablishing corner:

- H-03 [N1/4 COR SEC 10] NO CORNER EVIDENCE FOUND - REESTABLISHED THE CORNER POSITION AT THE MID-POINT BETWEEN AND ON LINE WITH THE SEC CORNERS 1/2 MILE TO THE EAST AND WEST. THIS POSITION CHECKS WELL WITH THE "GLO" DISTANCE EAST TO THE RIGHT BANK OF THE ESCANABA RIVER.
- H-05 [N1/4 COR SEC 15] NO CORNER EVIDENCE FOUND - REESTABLISHED THE CORNER POSITION AT THE MID-POINT BETWEEN AND ON LINE WITH THE SEC CORNERS 1/2 MILE TO THE EAST AND WEST AS PER THE 1927 RECORDS OF McNABB.

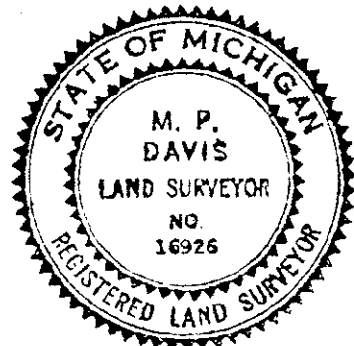

C. Description of monument for corner and accessories established to perpetuate locating the position of the corner:

- H-03 SET A BERNTSEN A1NB30 ALUM MONUMENT WITH THE CAP STAMPED TO ID THE CORNER POSITION.
 SURVEY MONUMENT SIGN POST MAPLE 13" BALSAM 13" ELM 09"
 EAST S75°W N46°W S03°E
 1.65' (TO FACE) 63.73' 5.20' 78.56'
- H-05 SET A BERNTSEN A1NB30 ALUM MONUMENT WITH THE CAP STAMPED TO ID THE CORNER POSITION.
 SURVEY MONUMENT SIGN POST W. BIRCH 13" W. BIRCH 06" SOFT MAPLE 06"
 NORTH N48°W S78°E S30°E
 1.61' 52.18' 53.40' 44.51'

NOTE: BEARINGS TO REFERENCE OBJECTS ARE MAGNETIC-DISTANCES ARE TO A NAIL W/A DELTA COUNTY REFERENCE TAG, UNLESS OTHERWISE NOTED.

Signed by M.P. Davis Date 7/13/00
 Surveyor's Michigan License No. 16926