

**SURVEY & REMONUMENTATION**

**OCT 03 2000**

**SECTION**

**LAND CORNER RECORDATION CERTIFICATE**  
Filing Requirement of Act 74, Mich. P.A. 1970

Approved By Delta County  
Land Survey Remonumentation  
Peer Group Under Act 345 of  
P.A. Of 1990 On July 12, 2000  
*Robert Shindler*  
Acting Chairman

For corners in

<u>DELTA</u> (County)	Located In:	Corner Code #
1. Public Land Survey	T 40 NR 23 W	I-10
	T 40 NR 23 W	I-12 ✓
	T ___ R ___	_____
	T ___ R ___	_____
2. Property Controlling in Section	S ___ T ___ R ___	_____
	S ___ T ___ R ___	_____
3. Miscellaneous Property in Sec.	S ___ T ___ R ___	_____
	S ___ T ___ R ___	_____

RECORDED 28 July 2000  
AT 9:00 O'CLOCK a.m.  
LIBER 9 PAGE 210  
*Walter C. Thomas*

DELTA COUNTY MI REG. OF DEEDS  
Register of Deeds Stamp & File Number

4. Lot No. \_\_\_\_\_, Recorded Plat \_\_\_\_\_  
5. Private Claims \_\_\_\_\_

I, M.P. DAVIS, in a field survey on JUNE, 2000 do hereby state that under requirements of P.A. 74, Michigan P.A. of 1970, the corner points mentioned in lines 1 and 2 above were in conformance with regulations and rules therefore as required in the current manual of survey instructions of the United States Department of the Interior, Bureau of Land Management or by a decree of a Court of Law and /or that the corner points mentioned in lines 3, 4 and 5 above were in conformance with the rules of the Michigan Board of Land Surveyors or by a Decree of a Court of Law; established, re-established, monumented, recovered, found as expressed below:

NOTE: Not more than 2 corners, all in the same town and range, may be recorded on this certificate.


	A	B	C	D	E	F	G	H	I	J	K	L	M
1													
2		6		5		4		3		2		1	
3													
4		7		8		9		10		11		12	
5													
6		18		17		16		15		14		13	
7													
8		19		20		21		22		23		24	
9													
10		30		29		28		27	●	26		25	
11													
12		31		32		33		34	●	35		36	
13													

A. Description of original monument and accessories and/or subsequent restoration:

- I-10 [W1/4 COR SEC 26] ALGERNON MERRYWEATHER, D.S.-1846-WOOD POST-(MAPLE 09" N28°E 14 LINKS)(BEECH 06" S57°W 45 LINKS) NO RECORD EVIDENCE OF CORNER RECOVERY AND/OR SUBSEQUENT CORNER MONUMENTATION
- I-12 [W1/4 COR SEC 35] ALGERNON MERRYWEATHER, D.S.-1846-WOOD POST-(HEMLOCK 06" N60°W 21 LINKS)(HEMLOCK 12" S60°E 07 LINKS) M.S.McNABB-1917-REAL OLD STAKE IN PLACE-SET BY STAKES SW & NE 25' M.S.McNABB-1942-STAKE IN PLACE FOUND PREVIOUS (S.MAPLE 10" S34°W 19.6')(W.BIRCH 08" S47°E 26.7') M.DAVIS-1975-FOUND STAKE IN PLACE-ID COR MONUMENT FROM McNABB'S MAPLE BY SW-REC'D L.2 OF LCR'S PG 116 (MAPLE 6" S70°E 17.7')(W.BIRCH 11" S8°W 35.8')(MAPLE 15" S48°W 13.0')(CORNER FENCE POST 2' WEST & 9" NORTH) SET A 4" X 4" X36" CONC. MON W/A 2-1/2" BRASS CAPS STAMPED TO ID THE CORNER POSITION.

B. Description of corner evidence found and/or method applied in restoring or reestablishing corner:

- I-10 [W1/4 COR SEC 15] NO CORNER EVIDENCE FOUND. REESTABLISHED CORNER POSITION AT JCT OF OLD FARM FENCES NORTH, EAST AND WEST. ACCEPTED THIS LOCATION AS BEING THE BEST AVAILABLE EVIDENCE AS TO THE POSITION OF THE ORIGINAL CORNER.
- I-12 [W1/4 COR SEC 35] FOUND IN PLACE THE CONC. MONUMENT AS PLACED BY MYSELF IN 1975. ACCEPTED EXISTING MONUMENT AS BEING THE BEST AVAILABLE EVIDENCE AS TO THE POSITION OF THE ORIGINAL CORNER.

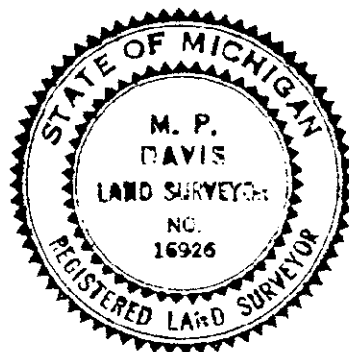

C. Description of monument for corner and accessories established to perpetuate locating the position of the corner:

- I-10 SET A 5/8" X 18" REBAR W/A 3-1/4" ALUM CAP STAMPED TO ID THE CORNER POSITION. CULTIVATED FARM FIELDS IN ALL 4 QUADRANTS - NO WIT'S AVAILABLE. (STEEL WITNESS POST SOUTH 1.30' TO FACE)(NW COR SEC 26 NO° 03' 45"E 2690.74') (SW COR SEC 26 S0° 14' 53"E 2700.50')
- I-12 DID NOT DISTURB EXISTING MONUMENT
 

MAPLE 11"	MAPLE 08"	MAPLE 11"	MAPLE 23"	STEEL WITNESS POST
N26°W	N45°E	S67°E	S64°W	SOUTH
27.63'	39.88'	17.70'	12.60'	2.50' (TO FACE)

NOTE: BEARINGS TO REFERENCE OBJECTS ARE MAGNETIC-DISTANCES ARE TO A NAIL W/A DELTA COUNTY REFERENCE TAG, UNLESS OTHERWISE NOTED.

Signed by M.P. Davis Date 7/13/00  
Surveyor's Michigan License No. 16926