

FEB 18 1994

COMMISSION

LAND CORNER RECORDATION CERTIFICATE
Filing Requirement of Act 74, Mich. P.A. 1970

Approved By Delta County Land Survey Remonumentation Peer Group Under Act 345 Of P.A. Of 1990 On Jan. 20, 1994
Acting Chairman

For corners in DELTA (County)

Located In: Corner Code --#

- 1. Public Land Survey T 40 N R 23 W H-9 & J-9
2. Property Controlling in Section S T R
3. Miscellaneous Property in Sec. S T R

Recorded January 21, 1994
9:00 a'clock .m. in Liber 7 Page 365
Walter C. Thomas Reg. of Deeds
Delta County, Michigan
Register of Deeds Stamp & File Number

- 4. Lot No. , Recorded Plat
5. Private Claims H-9 [N1/4 COR SEC 27] J-9 [N1/4 COR SEC 26]


Grid table with columns A-M and rows 2-13. Contains numbers 1-36 and two dots at row 9, columns G and H.

I, M.P. DAVIS, in a field survey on DECEMBER, 1993, do hereby certify that under requirements of P.A. 74, Michigan P.A. of 1970, the corner points mentioned in lines 1 and 2 above were in conformance with regulations and rules therefore as required in the current manual of survey instructions of the United States Department of the Interior, Bureau of Land Management or by a decree of a Court of Law and/or that the corner points mentioned in lines 3, 4 and 5 above were in conformance with the rules of the Michigan Board of Land Surveyors or by a Decree of a Court of Law; established, re-established, monumented, re-monumented, recovered, found as expressed below:

NOTE: Not more than 4 corners, all in the same town and range, may be recorded on this certificate.

- A. Description of original monument and accessories and/or subsequent restoration:
H-9 [N1/4 COR SEC 27] WOOD POST - A. MERRYWEATHER, D.S. - 1846 (HEMLOCK 10'-N70°E-6 LINKS) (HEMLOCK 8'-N80°W-29 LINKS)
C.E. BROTHERTON - DATE UNKNOWN - STAKE IN PLACE NO WIT' NOTED
M.S. McNABB - 1931 - ESTABLISHED CORNER POSITION AT EXISTING FENCE CORNER - SET I.P. - BT'S FENCE LINES N & S
J-9 [N1/4 COR SEC 26] WOOD POST - A. MERRYWEATHER, D.S. - 1846 (ELM 24'-S50°W-11 LINKS) (BEECH 10'-N53°E-69 LINKS)
D.A. BROTHERTON - 1895 - STAKE IN PLACE ID FROM ORIGINALS - NOTED MAPLE BT 22'-N6°W-49.3'
M.S. McNABB - 1931 - FOUND WOOD STAKE & MAPLE BT - SET I.P. NO WIT'S NOTED

- B. Description of corner evidence found and/or method applied in restoring or reestablishing corner:
H-9 [N1/4 COR SEC 27] NO EVIDENCE OF McNABB'S I.P. FOUND, HAS APPARENTLY BEEN DESTROYED DURING ROAD CONSTRUCTION - AS McNABB'S NOTES MENTION HIS CORNER BEING AT FENCES LINE N & S I HAVE REESTABLISHED THE CORNER POSITION ON LINE BETWEEN SEC COR'S E & W AND IN LINE WITH ANCIENT FENCE LINES N & S, DISTANCES E & W TO SEC CORNERS CHECKS WELL AGAINST McNABB'S MEASUREMENTS. ACCEPTED THIS POSITION AS BEING A CAREFUL & FAITHFUL REESTABLISHMENT OF THE POSITION OF THE ORIGINAL CORNER.
J-9 [N1/4 COR SEC 26] FOUND McNABB'S 1931 I.P. IN ROADBED OF E-W COUNTY ROAD, ID SAME FROM THE MAPLE BT NOTED BY BROTHERTON IN 1895 (THE BT IS NOW A STUMP DETERIORATED & IN POOR CONDITION. ACCEPTED THE EXISTING MON. AS A CAREFUL & FAITHFUL PERPETUATION OF THE POSITION OF THE ORIGINAL CORNER.

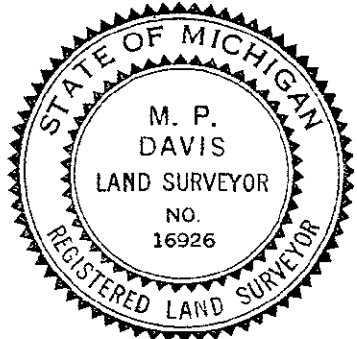

- C. Description of monument for corner and accessories established to perpetuate locating the position of the corner:
H-9 SET INSIDE A MON BOX A 5/8" X 18" REBAR W/A 3-1/4" ALUMN CAP STAMPED TO ID THE CORNER POSITION
DRILL HOLE IN FIELD STONE CEDAR 10" CEDAR 3" ELM 9" SURVEY MOUMENT SIGN POST
N20°W N3°E S53°E S71°W SOUTH
39.03' 48.15' 48.30' 68.55' 23.45' (TO FACE)
J-9 SET OVER EXISTING MON A 5/8" X 18" REBAR W/A 3-1/4" ALUMN CAP STAMPED TO ID THE COR POSITION & RAISED TO RD SURFACE W/A MON BOX
POWER POLE SW COR OF HOUSE POWER POLE POWER POLE
N9°E N52°E S50°E S58°W
72.54' (TO FACE) 71.33' 59.51' (TO FACE) 59.42' (TO FACE)

NOTE: BEARINGS TO REFERENCE OBJECTS ARE MAGNETIC & DISTANCES ARE TO A NAIL IN THE CENTER OF THE OBJECT UNLESS OTHERWISE NOTED

Signed by M.P. Davis Date 12/30/93
Surveyor's Michigan License No. 16926