

SURVEY & REMONUMENTATION

OCT 03 2000

SECTION

LAND CORNER RECORDATION CERTIFICATE
Filing Requirement of Act 74, Mich. P.A. 1970

Approved By Delta County
Land Survey Remonumentation
Peer Group Under Act 345 of
P.A. Of 1990 On July 12, 2000
Robert Schmeling
Acting Chairman

For corners in

DELTA (County)	Located in:	Corner Code #
1. Public Land Survey	T 40 N R 23 W	K-11 ✓
	T 40 N R 23 W	L-05
	T R	
	T R	
2. Property Controlling in Section	S T R	
	S T R	
3. Miscellaneous Property in Sec.	S T R	
	S T R	

RECORDED 28 July 2000
AT 9:00 O'CLOCK a.m.
LIBER 9 PAGE 221
William C. Thomas
DELTA COUNTY MI REG. OF DEEDS
Register of Deeds Stamp & File Number

K-11 [NW COR SEC 36] L-05 [N1/4 COR SEC 13]

4. Lot No. _____, Recorded Plat _____
5. Private Claims _____

I, M.P. DAVIS, in a field survey on MAY, 2000 do hereby state that under requirements of P.A. 74, Michigan P.A. of 1970, the corner points mentioned in lines 1 and 2 above were in conformance with regulations and rules therefore as required in the current manual of survey instructions of the United States Department of the Interior, Bureau of Land Management or by a decree of a Court of Law and /or that the corner points mentioned in lines 3, 4 and 5 above were in conformance with the rules of the Michigan Board of Land Surveyors or by a Decree of a Court of Law; established, re-established, monumented, recovered, found as expressed below:

NOTE: Not more than 2 corners, all in the same town and range, may be recorded on this certificate.


	A	B	C	D	E	F	G	H	I	J	K	L	M
1													
2	6		5		4		3		2		1		
3													
4	7		8		9		10		11		12		
5													
6	18		17		16		15		14		13		
7													
8	19		20		21		22		23		24		
9													
10	30		29		28		27		26		25		
11													
12	31		32		33		34		35		36		
13													

A. Description of original monument and accessories and/or subsequent restoration:

- K-11 [NW COR SEC 36] A.MERRYWEATHER, D.S. -1846-SET POST-(BIRCH 20" N58°E 11 LINKS)(CEDAR 24" S18°W 21 LINKS) ROBERT E. SCHMELING - 1958 - RESTORED COR BY PROPORTIONAL MEASUREMENT BETWEEN COR'S EAST & WEST & "GLO" DISTANCES TO THE ESCANABA RIVER. SET A 1-1/2" IRON PIPE W/A BRASS CAP STAMPED TO ID THE CORNER POSITION. CEDAR 6" S70°E 49.3' CEDAR 5" S25°E 74.9'
- L-05 [N1/4 COR SEC 13] A. MERRYWEATHER, D.S. 1846 - (HEMLOCK 06" S70°E 03 LINKS) (BEECH 24" N64°E 35 LINKS) M.S.McNABB-1914 - ID BY ORIGINALS M.S.McNABB-1932 - STAKE & BT'S IN PLACE FROM PREVIOUS SURVEY - HEMLOCK 9" N55°W 1.4' M.S.McNABB-1944 - STAKE IN PLACE HEMLOCK 9" N42°E 66.0' ROBERT E. SCHMELING - 1987 -L.5 LCR'S PG 311 - FOUND I.P. W/A SURVEY CAP AS ESTABLISHED BY MY SELF PREVIOUS BY RETRACEMENT OF McNABB'S N-S 1/4 LINE OF SEC 13 C/L PP N37°E 37.5' MAPLE 11" S78°E 38.5' MAPLE 9" S75°W 51.7'

B. Description of corner evidence found and/or method applied in restoring or reestablishing corner:

- K-11 [NW COR SEC 36] FOUND IN PLACE A 1-1/4" IRON PIPE W/A BRASS CAP ATTACHED THERETO AND STAMPED TO ID THE4 CORNER POSITION. WOULD APPEAR THE SCHMELING BT'S HAVE ALL BEEN DESTROYED BY RECENT CLEARING OF THE RR R/W. ACCEPTED EXISTING MONUMENT AS BEING A CAREFUL AND FAITHFUL REESTABLISHMENT OF THE CORNER POSITION.
- L-05 [N1/4 COR SEC 13] FOUND IN PLACE A 1" X 18" I.P. W/A SURVEY CAP ATTACHED THERETO. ID CORNER MON AS THAT SET BY MY SELF FROM THE SCHMELING MAPLE BT'S SE & SW WHICH ARE STILL GREEN. ACCEPTED THE EXISTING MONUMENT AS BEING A CREFUL & FAITHFUL PERPETUATION OF THE POSITION OF THE ORIGINAL CORNER.

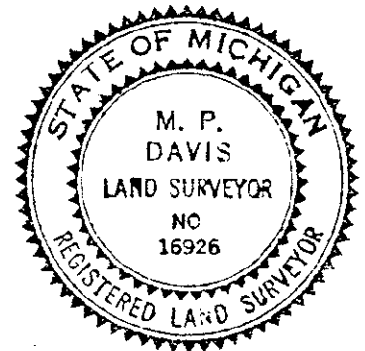

C. Description of monument for corner and accessories established to perpetuate locating the position of the corner:

- K-11 DID NOT DISTURB EXISTING MONUMENT AND NOTED NEW BT'S

SURVEY MONUMENT SIGN POST	MAPLE 18"	CEDAR 07"	CEDAR 08"	CEDAR 09"
N68°W	N72°E	EAST	S43°E	S23°E
2.62' (TO FACE)	99.11'	58.06'	48.90'	84.63'
- L-05 REPLACED EXISTING MONUMENT W/A 5/8" X18" REBAR W/A 3-1/4" ALUM CAP STAMPED TO ID THE CORNER POSITION.

SURVEY MONUMENT SIGN POST	MAPLE 15" (OLD BT)	HEMLOCK 11"	MAPLE 15"(OLD BT)	C/L 4" STEEL GATE POST
NO 7E	S75°E	S43°E	S80°W	N16°W
18.06' (TO FACE)	38.23'	46.36'	51.90'	33.60'

NOTE: BEARINGS TO REFERENCE OBJECTS ARE MAGNETIC-DISTANCES ARE TO A NAIL W/A DELTA COUNTY REFERENCE TAG, UNLESS OTHERWISE NOTED.

Signed by M.P. Davis Date 7/13/00
Surveyor's Michigan License No. 16926