

SURVEY & REMONUMENTATION

OCT 03 2000

SECTION

LAND CORNER RECORDATION CERTIFICATE
Filing Requirement of Act 74, Mich. P.A. 1970

Approved By Delta County
Land Survey Remonumentation
Peer Group Under Act 345 of
P.A. Of 1990 On July 12 20 00
Robert Schmeling
Acting Chairman

For corners in

DELTA (County)	Located In:	Corner Code #
1. Public Land Survey	T 40 N R 23 W	L-06
	T 40 N R 23 W	L-09 ✓
	T R	
	T R	
	T R	
2. Property Controlling in Section	S T R	
	S T R	
	S T R	
3. Miscellaneous Property in Sec.	S T R	
	S T R	

L-06 [C1/4 COR SEC 13] L-09 [N1/4 COR SEC 25]

RECORDED 28 July 2000
AT 9:00 O'CLOCK a.m.
LIBER 9 PAGE 217
Watson C. Thomas
DELTA COUNTY MI REG. OF DEEDS

Register of Deeds Stamp & File Number

4. Lot No. _____, Recorded Plat _____
5. Private Claims _____

I, H.P. DAVIS, in a field survey on MAY, 00 do hereby state that under requirements of P.A. 74, Michigan P.A. of 1970, the corner points mentioned in lines 1 and 2 above were in conformance with regulations and rules therefore as required in the current manual of survey instructions of the United States Department of the Interior, Bureau of Land Management or by a decree of a Court of Law and /or that the corner points mentioned in lines 3, 4 and 5 above were in conformance with the rules of the Michigan Board of Land Surveyors or by a Decree of a Court of Law, established, re-established, monumented, recovered, found as expressed below:

	A	B	C	D	E	F	G	H	I	J	K	L	M
1													
2	6	5	4	3	2	1							
3													
4	7	8	9	10	11	12							
5													
6	18	17	16	15	14								
7													
8	19	20	21	22	23	24							
9													
10	30	29	28	27	26	25							
11													
12	31	32	33	34	35	36							
13													


NOTE: Not more than 2 corners, all in the same town and range, may be recorded on this certificate.

A. Description of original monument and accessories and/or subsequent restoration:

- L-06 [C1/4 COR SEC 13] NOT SET IN ORIGINALS
M.S.McNABB-1944-FOUND IRON PIPE IN PLACE AT INTERSECTION OF 1/4 LINES. PINE STUMP 18" S55°W 56' POPPLE 6" N60°E 36.8'
- L-09 [N1/4 COR SEC 25] A.MERRYWEATHER, D.S.-1846- WOOD POST (CEDAR 06" N39°W 15 LINKS)(CEDAR 12" S08°E 8.5 LINKS)
D.A.BROTHERTON - 1895- ORIGINALS GONE SET 1/2 DISTANCE BETWEEN CORNERS TELE POLE S45°E 31' TELE POLE N20°E 56'
M.S.McNABB-1925-CORNER FALLS IN BACK WATER OF DAM
R.E.SCHMELING-1959-L.3 OF LCR'S PG 73- REESTABLISHED COR FROM RECORDS OF McNABB-SET AN IRON PIPE W/A BRASS CAP STAMPED TO ID THE CORNER POSITION. SCHMELING'S ACCESSORIES HAVE ALL BEEN DESTROYED DURING RECONSTRUCTION OF COUNTY ROAD 420 BRIDGE OVER THE ESCANABA RIVER.

B. Description of corner evidence found and/or method applied in restoring or reestablishing corner:

- L-06 [C1/4 COR SEC 13] FOUND IN PLACE A 1-1/2" IRON PIPE. ID SAME AS THAT BEING FOUND IN PLACE IN 1944 BY McNABB FROM HIS PINE STUMP BT WHICH IS STILL IN PLACE AND BADLY DETERIORATED. ACCEPTED EXISTING MONUMENT AS BEING A CAREFUL AND FAITHFUL ESTABLISHMENT OF THE CORNER POSITION.
- L-09 [N1/4 COR SEC 25] FOUND IN PLACE AND NEAR THE MIDPOINT BETWEEN SEC CORNERS 1/2 MILE E & W SCHMELING'S IRON PIPE W/A BRASS CAP. ACCEPTED EXISTING MONUMENT AS BEING A CAREFUL AND FAITHFUL REESTABLISHMENT OF THE POSITION OF THE ORIGINAL CORNER.

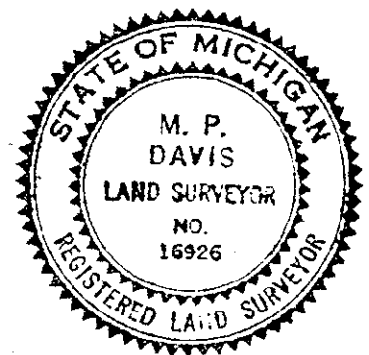

C. Description of monument for corner and accessories established to perpetuate locating the position of the corner:

- L-06 SET, OVER EXISTING MONUMENT, A BERNTSEN A1NB30 ALUM MONUMENT WITH THE CAP STAMPED TO ID THE CORNER POSITION

MAPLE 14"	W.BIRCH 15"	MAPLE 20"	MAPLE 14"	SURVEY MONUMENT SIGN POST
N55°E	N35°W	S39°E	S45°W	WEST
64.46'	41.05'	47.16'	35.97	1.81'(TO FACE)
- L-09 DID NOT DISTURB EXISTING MONUMENT

C/L GUARD RAIL POSTS	C/L COUNTY ROAD 420	SURVEY MONUMENT SIGN POST
N44°W	N64°E	NORTH
02.95'	05.22'	22.00'
		S55°E
		1.32'(TO FACE)

NOTE: BEARINGS TO REFERENCE OBJECTS ARE MAGNETIC-DISTANCES ARE TO A NAIL W/A DELTA COUNTY REFERENCE TAG, UNLESS OTHERWISE NOTED.

Signed by M. P. Davis Date 7/13/00
Surveyor's Michigan License No. 16926