

FEB 18 1994

COMMISSION

LAND CORNER RECORDATION CERTIFICATE
Filing Requirement of Act 74, Mich. P.A. 1970

Approved By Delta County Land Survey Remonumentation Peer Group Under Act 345 Of P.A. Of 1990 On Jan. 20, 1994
Acting Chairman

For corners in

DELTA (County)

Located In:

Corner Code #

- 1. Public Land Survey T 40 NR 23 W M-6 & M-7
2. Property Controlling in Section S T R
3. Miscellaneous Property in Sec. S T R

Recorded January 21, 1994

9:00 o'clock a.m. in Liber 7 page 374

Walter C. Thoman Reg. of Deeds Delta County, Michigan

Register of Deeds Stamp & File Number

- 4. Lot No. Recorded Plat
5. Private Claims M-6 [E1/4 COR SEC 13] M-7 [SE COR SEC 13]

Grid table with columns A-M and rows 2-13. Contains numerical data points for survey locations.

I, M.P. DAVIS, in a field survey on DECEMBER, 19 93, do hereby certify that under requirements of P.A. 74, Michigan P.A. of 1970, the corner points mentioned in lines 1 and 2 above were in conformance with regulations and rules therefore as required in the current manual of survey instructions of the United States Department of the Interior, Bureau of Land Management or by a decree of a Court of Law and/or that the corner points mentioned in lines 3, 4 and 5 above were in conformance with the rules of the Michigan Board of Land Surveyors or by a Decree of a Court of Law; established, re-established, monumented, re-monumented, recovered, found as expressed below:


NOTE: Not more than 4 corners, all in the same town and range, may be recorded on this certificate.

A. Description of original monument and accessories and/or subsequent restoration:

- M-6 [E1/4 COR SEC 13] WOOD POST - WM. A. BURT, D.S. - 1844 (HEMLOCK 14°-N26°E-14 LINKS) (HEMLOCK 14°-S62°W-11 LINKS)
M.S. McNABB - 1915 - STAKE IN PLACE CLAIMED BY SETTLERS TO HAVE BEEN SET FROM ORIGINALS-RESET NEW STAKE & BT STAKES NE -SW 33'
M.S. McNABB - 1944 -STAKE IN PLACE FROM PREVIOUS SURVEY-SET ANGLE IRON - HEMLOCK 14°-S15°E-50'
M-7 [SE COR SEC 13] WOOD POST -WM. A. BURT, D.S. - 1844 (Y.BIRCH 5°-N70°E-25 LINKS) (HEMLOCK 20°-S12°W-22 LINKS)
M.S. McNABB - 1915 - ID FROM BOTH ORIGINALS, Y.BIRCH DOWN - BT STAKES NE & SE 33'
M.S. McNABB - 1944 - IRON STAKE IN PLACE FROM PREVIOUS SURVEY-COR FENCE POST-S50°E-44.2'

B. Description of corner evidence found and/or method applied in restoring or reestablishing corner:

- M-6 [E1/4 COR SEC 13] FOUND IN PLACE McNABB'S 1944 ANGLE IRON FROM WHICH A HEMLOCK STUMP BEARS S15°E-50' (STUMP IS NOW IN POOR CONDITIONS-IRON MARKS NOT VISIBLE), ACCEPTED THIS MONUMENT AS BEING A CAREFUL & FAITHFUL PERPETUATION OF THE POSITION OF THE ORIGINAL CORNER.
M-7 [SE COR SEC 13] FOUND 1" IRON PIPE AT JCT OF COUNTY ROADS E-W & N-NO EVIDENCE OF McNABB'S BT FENCE COR - DISTANCES E-W & N TO ADJOINING CORNERS CHECK WELLS WITH McNABB'S RECORDS. ACCEPTED EXISTING MONUMENT AS BEING A CAREFUL & FAITHFUL PERPETUATION OF THE POSITION OF THE ORIGINAL CORNER.

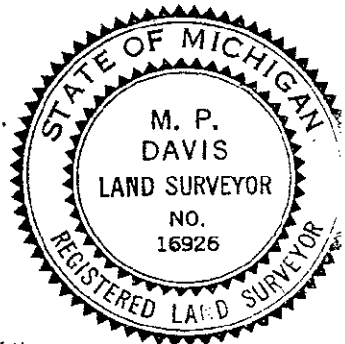

C. Description of monument for corner and accessories established to perpetuate locating the position of the corner:

- M-6 REPLACE ANGLE IRON W/A 4" X 4" X 36" CONCRETE MONUMENT W/A BRASS CAP STAMPED TO ID THE CORNER POSITION
MAPLE 8" MAPLE 6" MAPLE 11" MAPLE 13" SURVEY MONUMENT SIGN POST
N6°W N38°E S37°E S45°W SOUTH
21.63' 16.40' 35.40' 23.00' 3.11' (TO FACE)
M-7 SET OVER EXISTING MON A 5/8" X 18" REBAR W/A 3-1/4" ALUMN CAP STAMPED TO ID THE COR POSITION & RAISED TO RD SURFACE W/A MON BOX
SURVEY MONUMENT SIGN POST POWER POLE POWER POLE SPRUCE 5"
N38°W N50°E S38°E S52°W
43.27' (TO FACE) 43.10' (TO FACE) 44.18' (TO FACE) 49.75'

NOTE: BEARINGS TO REFERENCE OBJECTS ARE MAGNETIC & DISTANCES ARE TO A NAIL IN THE CENTER OF THE OBJECT UNLESS OTHERWISE NOTED

Signed by M.P. Davis Date 12/30/93

Surveyor's Michigan License No. 16926