

SURVEY & REMONUMENTATION

JAN 14 1998

Approved By Delta County
Land Survey Remonumentation
Peer Group Under Act 345 Of
P.A. Of 1990 On 12/18, 1997

Robert Schmeling
Acting Chairman

SECTION _____

LAND CORNER RECORDATION CERTIFICATE

Filing Requirement of Act 74, Mich. P.A. 1970

For corners in
DELTA

	Located In:	Corner Code #/	
(County)			
1. Public Land Survey	T <u>40N</u> R <u>24W</u>	<u>A-9</u> & <u>B-9</u>	
	T <u>40N</u> R <u>25W</u>	<u>M-9</u>	
	T _____ R _____	_____	_____
	T _____ R _____	_____	_____
2. Property Controlling in Section	S _____ T _____ R _____	_____	_____
	S _____ T _____ R _____	_____	_____
3. Miscellaneous Property in Sec.	S _____ T _____ R _____	_____	_____
	S _____ T _____ R _____	_____	_____

Date: Dec 19 1997
Time: 9:00 AM
Page: 8 of 287
Walter C. Thomas
Delta County Register of Deeds

Register of Deeds Stamp & File Number

4. Lot No. _____, Recorded Plat _____
5. Private Claims _____
A-9 [SW COR SEC 19]-(SAME AS M-9) B-9 [1/4 COR COMMON TO SEC'S 19/30]


	A	B	C	D	E	F	G	H	I	J	K	L	M
2	6	5	4	3	2	1							
3													
4	7	8	9	10	11	12							
5													
6	13	17	16	15	14	13							
7													
8	19	20	21	22	23	24							
9	●												
10	30	29	28	27	26	25							
11													
12	31	32	33	34	35	36							
13													

I, M.P. DAVIS, in a field survey on NOVEMBER, 1996, do hereby certify that under requirements of P.A. 74, Michigan P.A. of 1970, the corner points mentioned in lines 1 and 2 above were in conformance with regulations and rules therefore as required in the current manual of survey instructions of the United States Department of the Interior, Bureau of Land Management or by a decree of a Court of Law and/or that the corner points mentioned in lines 3, 4 and 5 above were in conformance with the rules of the Michigan Board of Land Surveyors or by a Decree of a Court of Law; established, re-established, monumented, re-monumented, recovered, found as expressed below:

NOTE: Not more than 4 corners, all in the same town and range, may be recorded on this certificate.

- A. Description of original monument and accessories and/or subsequent restoration:**
- A-9 [SW COR SEC 19] WOOD POST J. MULLETT D.S. 1848 (SUGAR 15°-N73°W-24 LINKS)(BEECH 6°-S18°W-41 LINKS) H. MILLEN D.S. 1852 (SUGAR 10°-S73°E-14 LINKS)(ELM 18°-N60°E-3 LINKS) M.P. DAVIS 1972 - FOUND IN PLACE A 3/4" IRON BAR SET BY PERSONS UNKNOWN (ROAD SIGN POST-S8°E-26.8 FEET)(IRONWOOD 4°-N35°W-31.9 FEET)
 - B-9 [1/4 CORNER COMMON TO SEC'S 19/30] WOOD POST H. MILLEN D.S. 1952 (SUGAR 14°-S34 1/2°W-49 LINKS)(YELLOW BIRCH 6°-S46°E-20 LINKS) M.P. DAVIS 1972 - FOUND IN PLACE A 3/4" IRON BAR SET BY PERSONS UNKNOWN (ELM 15°-S18°W-45.5 FEET)(TWIN ELM S68°W-20.2 FEET)(ROAD CENTERLINE SOUTH-29.0 FEET)

- B. Description of corner evidence found and/or method applied in restoring or reestablishing corner:**
- A-9 [SW COR SEC 19] FOUND THIS DATE DAVIS 1972 IRON BAR - IRONWOOD WITNESS IN PLACE - ROAD SIGN POST GONE. ACCEPTED EXISTING MONUMENT AS BEING THE BEST AVAILABLE EVIDENCE AS TO THE LOCATION OF THE POSITION OF THE ORIGINAL CORNER.
 - B-9 [1/4 COR COMMON TO SEC'S 19/30] FOUND THIS DATE DAVIS 1972 IRON BAR - BOTH ELM WITNESSES GONE AREA BULLDOZED FOR ROAD CONSTRUCTION. IDENTIFIED CORNER MONUMENT BY PREVIOUSLY ESTABLISHED MEASUREMENTS TO ADJOINING CORNERS. ACCEPTED EXISTING MONUMENT AS BEING THE BEST AVAILABLE EVIDENCE AS TO THE LOCATION OF THE POSITION OF THE ORIGINAL CORNER.

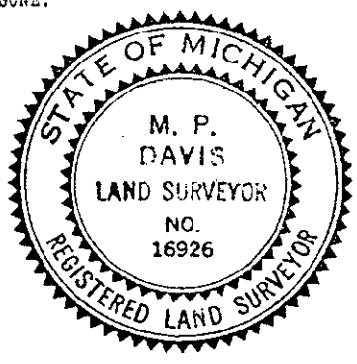

- C. Description of monument for corner and accessories established to perpetuate locating the position of the corner:**
- A-9 REPLACED IRON BAR W/A 5/8" X 18" REBAR (6" BELOW GRADE) W/A 3 1/4" ALUMN CAP STAMPED TO ID THE CORNER POSITION.
 1972 IRONWOOD 5' BASSWOOD 6" POWER POLE #10 SURVEY MONUMENT SIGN POST
 N35°W N81°E S27°E S10°W
 31.90' 51.52' 60.14 TO FACE 32.31 TO FACE
 - B-9 REPLACED IRON BAR W/A 5/8" X 18" REBAR (6" BELOW GRADE) W/A 3 1/4" ALUMN CAP STAMPED TO ID THE CORNER POSITION.
 MAPLE 4" MAPLE 6" CHISLED "X" TOP OF CONC. GATE SUPPORT SW COR GARAGE SURVEY MONUMENT SIGN POST
 N65°W S54°E S7°W N80°E S79°W
 16.11' 32.94' 72.95' 53.40' 28.61' TO FACE

NOTE: BEARINGS TO REFERENCE OBJECTS ARE MAGNETIC & DISTANCES ARE TO A NAIL W/A REFERENCE TAG UNLESS OTHERWISE NOTED.

Signed by M.P. Davis Date 12/14/97
Surveyor's Michigan License No. 16926