

SURVEY & REMONUMENTATION

JAN 14 1998

SECTION

LAND CORNER RECORDATION CERTIFICATE
Filing Requirement of Act 74, Mich. P.A. 1970

Approved By Delta County
Land Survey Remonumentation
Peer Group Under Act 345 Of
P.A. Of 1990 On 12/18, 1997

Robert E. Schmeling
Acting Chairman

For corners in
DELTA
(County)

Located In: Corner Code #

1. Public Land Survey	T 40N R24W	A-7 & B-7
	T 40N R25W	M-7
	T _____ R _____	_____
	T _____ R _____	_____
2. Property Controlling in Section	S _____ T _____ R _____	_____
	S _____ T _____ R _____	_____
3. Miscellaneous Property in Sec.	S _____ T _____ R _____	_____
	S _____ T _____ R _____	_____

Dec 19 1997
9:00 AM
8
Walter C. Thomas

Register of Deeds Stamp & File Number

4. Lot No. _____, Recorded Plat _____
5. Private Claims
A-7 [NW COR SEC 19]-(SAME AS M-7) B-7 [1/4 COR COMMON TO SEC'S 18/19]

A	B	C	D	E	F	G	H	I	J	K	L	M
2	6	5	4	3	2	1						
3												
4	7	8	9	10	11	12						
5												
6	18	17	16	15	14	13						
7	19	20	21	22	23	24						
8												
9												
10	30	29	28	27	26	25						
11												
12	31	32	33	34	35	36						
13												

I, M.P. DAVIS, in a field survey on NOVEMBER, 19 96, do hereby certify that under requirements of P.A. 74, Michigan P.A. of 1970, the corner points mentioned in lines 1 and 2 above were in conformance with regulations and rules therefore as required in the current manual of survey instructions of the United States Department of the Interior, Bureau of Land Management or by a decree of a Court of Law and/or that the corner points mentioned in lines 3, 4 and 5 above were in conformance with the rules of the Michigan Board of Land Surveyors or by a Decree of a Court of Law; established, re-established, monumented, re-monumented, recovered, found as expressed below:

NOTE: Not more than 4 corners, all in the same town and range, may be recorded on this certificate.

A. Description of original monument and accessories and/or subsequent restoration:


A-7 [NW COR SEC 19] WOOD POST - J. MULLETT D.S. 1848 (CEDAR 10"-N53°W-18 LINKS)(CEDAR 15"-S84°W-24 LINKS)
H. MILLEN D.S. 1852 (CEDAR 18"-N19°E-16 LINKS)(CEDAR 10"-S7 1/2°E-31 LINKS)
M.P. DAVIS 1976-IDENTIFIED MULLETT'S GLO CEDARS-SET 3/4" X 18" IRON PIPE (BALSAM 6"-N64°W-15.4 FEET)
(BALSAM 9"-S10°W-16.8 FEET)

B-7 [1/4 COR COMMON TO SEC'S 18/19] WOOD POST - H. MILLEN D.S. 1852 (CEDAR 8"-N81°W-20 LINKS)(CEDAR 6"-S68°E-32 LINKS)
M.P.DAVIS 1976-FOUND SQUARED POST (SPRUCE 10"-S68°E-32.8 FEET)(BALSAM 7"-N44°E-29.3 FEET)

B. Description of corner evidence found and/or method applied in restoring or reestablishing corner:

A-7 [NW COR SEC 19] FOUND THIS DATE DAVIS 1976 IRON PIPE - BOTH BALSAM WITNESSES DEAD & DOWN, ACCEPTED EXISTING MONUMENT AS BEING A CAREFUL AND FAITHFUL PERPETUATION OF THE POSITION OF THE ORIGINAL CORNER.

B-7 [1/4 COR COMMON TO SEC'S 18/19] FOUND DAVIS 1976 WOOD POST & SPRUCE WITNESS (NOW A SNAG) AREA NOW A CLEAR CUT ACCEPTED EXISTING MONUMENT AS BEING THE BEST AVAILABLE EVIDENCE AS TO THE LOCATION OF THE POSITION OF THE ORIGINAL CORNER.

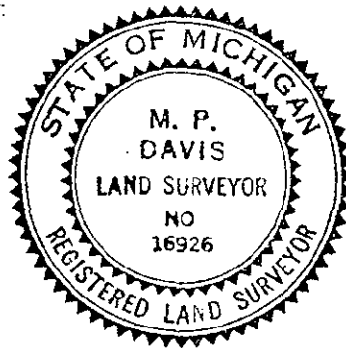

C. Description of monument for corner and accessories established to perpetuate locating the position of the corner:

A-7 REPLACED IRON PIPE WITH A BERNTSEN AINB36 ALUMN MONUMENT W/A 3 1/4" CAP STAMPED TO IDENTIFY THE CORNER POSITION.
BALSAM 8" CEDAR 6" CEDAR 7" CEDAR 6" SURVEY MONUMENT SIGN POST
N6°W S80°E S2°W S76°E N75°W
19.62' 32.79' 44.87' 41.12' 2.48' TO BACK

B-7 REPLACED WOOD POST WITH A BERNTSEN AINB36 ALUMN MONUMENT W/A 3 1/4" CAP STAMPED TO IDENTIFY THE CORNER POSITION.
SPRUCE SNAG 15" BALSAM 3" BALSAM 3" SURVEY MONUMENT SIGN POST
S68°E S47°W N79°E NORTH
32.80' 10.77' 15.78' 1.94' TO FACE

NOTE: BEARINGS TO REFERENCE OBJECTS ARE MAGNETIC AND DISTANCES ARE TO A NAIL W/A REFERENCE TAG UNLESS OTHERWISE NOTED.

Signed by M.P. Davis Date 12/4/97
Surveyor's Michigan License No. 16926