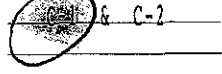


Walter C. Thorne
Acting Chairman

LAND CORNER RECORDATION CERTIFICATE
Filing Requirement of Act 74, Mich. P.A. 1970

For corners in
DELTA
(County)

Located In: Corner Code 77

- | | | |
|------------------------------------|-----------------------------|-----------------------------------------------------------------------------------|
| 1. Public Land Survey | T <u>40 N</u> R <u>24 W</u> |  |
| | T _____ R _____ | |
| | T _____ R _____ | |
| | T _____ R _____ | |
| 2. Property Controlling in Section | S _____ T _____ R _____ | |
| | S _____ T _____ R _____ | |
| 3. Miscellaneous Property in Sec. | S _____ T _____ R _____ | |
| | S _____ T _____ R _____ | |

MAY 13 1994

Recorded
9:00 AM In Liber 7 Page 402
Walter C. Thorne Reg. of Deeds.
Delta County, Michigan
Register of Deeds Stamp & File Number

4. Lot No. _____, Recorded Plat _____
5. Private Claims _____
C-1 [NW COR SEC 5] C-2 [W1/4 COR SEC 5]

	A	B	C	D	E	F	G	H	I	J	K	L	M
2	6	5	4	3	2	1							
3													
4	7	8	9	10	11	12							
5													
6	13	17	16	15	14	13							
7													
8	19	20	21	22	23	24							
9													
10	30	29	28	27	26	25							
11													
12	31	32	33	34	35	36							
13													

I, M.P. DAVIS, in a field survey on MARCH, 19 94, do hereby certify that under requirements of P.A. 74, Michigan P.A. of 1970, the corner points mentioned in lines 1 and 2 above were in conformance with regulations and rules therefore as required in the current manual of survey instructions of the United States Department of the Interior, Bureau of Land Management or by a decree of a Court of Law and/or that the corner points mentioned in lines 3, 4 and 5 above were in conformance with the rules of the Michigan Board of Land Surveyors or by a Decree of a Court of Law; established, re-established, monumented, re-monumented, recovered, found as expressed below:


NOTE: Not more than 4 corners, all in the same town and range, may be recorded on this certificate.

A. Description of original monument and accessories and/or subsequent restoration:

- C-1 [NW COR SEC 5] HARVEY MILLEN, D.S. - 1852 - WOOD POST (Y. BIRCH 12"-S44°W-25 LINKS) (BEECH 12"-S20°E-62 LINKS) 1933 -M.S. McNABB, ROAD ALIGNMENT SURVEY FOR CORNELL TWP. - NO EVIDENCE OF CORNER POSITION FOUND-ESTABLISHED CORNER 49.5' EAST OF COR OF SEC 34 T41N R24W & SET IP (MAPLE 7"-N10°E-19.2') (POPLAR 12"-S30°E-9.2')
- C-2 [W1/4 COR SEC 5] HARVEY MILLEN, D.S. - 1852 - WOOD POST - (SPRUCE 09"-N29°E-19 LINKS) (W. BIRCH 09"-S35°W-09 LINKS) 1933 -M.S. McNABB, ROAD ALIGNMENT SURVEY FOR CORNELL TWP. - NO EVIDENCE OF CORNER POSITION FOUND SET COR AT PROPORTIONATE DISTANCE BETWEEN CORNERS, SET IP (CEDAR 6" S75°E-71')

B. Description of corner evidence found and/or method applied in restoring or reestablishing corner:

- C-1 [NW COR SEC 5] FOUND 1-1/4" IP IN PLACE AS INDICATED BY ROAD IMPROVEMENTS & OCCUPATION. DISTANCE SOUTH TO SW COR OF SEC 5 CORRESPONDS WELL WITH McNABB'S RECORDS. ACCEPTED THIS POSITION AS BEING A CAREFUL & FAITHFUL REESTABLISHMENT OF THE POSITION OF THE ORIGINAL CORNER.
- C-2 [W1/4 COR SEC 5] FOUND 1-1/4" IP IN EAST WHEEL PATH OF N-S COUNTY ROAD. CORNER IS 1.33' EAST OF DIRECT LINE BETWEEN SEC CORNERS N & S AND THE DISTANCE BETWEEN CORNERS FITS PROPORTIONATELY. ACCEPTED THIS POSITION AS A CAREFUL & FAITHFUL REESTABLISHMENT OF THE ORIGINAL CORNER.

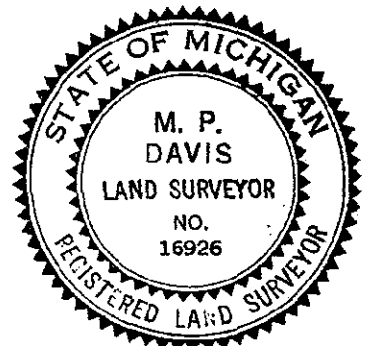

C. Description of monument for corner and accessories established to perpetuate locating the position of the corner:

- C-1 SET, INSIDE EXISTING IP & 4" M/L BELOW THE ROAD SURFACE, A 5/8" X 18" REBAR W/A 3-1/4" ALUMN CAP STAMPED TO ID THE CORNER POSITION
- | | | | |
|----------|---------------------------|----------|------------------|
| MAPLE 6" | SURVEY MONUMENT SIGN POST | BEECH 5" | MAPLE (TWIN) 14" |
| N26°E | N41°W | S25°E | S30°W |
| 43.28' | 8.50' (TO FACE) | 64.60' | 79.91' |
- C-2 SET, INSIDE EXISTING IP & 6" M/L BELOW ROAD SURFACE, A 5/8" X 18" REBAR W/A 3-1/4" ALUMN CAP STAMPED TO ID THE CORNER POSITION.
- | | | | | |
|-------------|---------------------------|--------------|--------------|------------------|
| TAMARACK 9" | SURVEY MONUMENT SIGN POST | TAMARACK 18" | TAMARACK 18" | POWER POLE |
| S53°W | EAST | S50°E | N18°E | N70°W |
| 57.47' | 11.17' (TO FACE) | 115.85' | 77.54' | 66.13' (TO FACE) |

NOTE: BEARINGS TO REFERENCE OBJECTS ARE MAGNETIC & DISTANCES ARE TO A NAIL W/A REFERENCE TAG, UNLESS NOTED OTHERWISE

Signed by M.P. Davis Date 4/4/94
Surveyor's Michigan License No. 16926