

# SURVEY & REMONUMENTATION

JAN 14 1998

Approved By Delta County  
Land Survey Remonumentation  
Peer Group Under Act 345 Of  
P.A. Of 1990 On 12/18, 1997

## LAND CORNER RECORDATION CERTIFICATE

Filing Requirement of Act 74, Mich. P.A. 1970

*Richard Schmeling*  
Acting Chairman

### SECTION

For corners in DELTA <small>(County)</small>	Located in:	Corner Code #
1. Public Land Survey	T 40N R24W	I-4 & I-5
	T _____ R _____	_____
	T _____ R _____	_____
	T _____ R _____	_____
2. Property Controlling in Section	S _____ T _____ R _____	_____
	S _____ T _____ R _____	_____
3. Miscellaneous Property in Sec.	S _____ T _____ R _____	_____
	S _____ T _____ R _____	_____

Dec 19 1997  
9:00 AM  
8 26.3

Register of Deeds Stamp & File Number

4. Lot No. \_\_\_\_\_, Recorded Plat \_\_\_\_\_
5. Private Claims  
I-4 [1/4 COR COMMON TO SEC'S 10/11] I-5 [SE COR SEC 10]

	A	B	C	D	E	F	G	H	I	J	K	L	M
2	6	5	4	3	2	1							
3													
4	7	8	9	10	11	12							
5													
6	18	17	16	15	14	13							
7													
8	19	20	21	22	23	24							
9													
10	30	29	28	27	26	25							
11													
12	31	32	33	34	35	36							
13													

I, M.P. DAVIS, in a field survey on NOVEMBER, 19 97, do hereby certify that under requirements of P.A. 74, Michigan P.A. of 1970, the corner points mentioned in lines 1 and 2 above were in conformance with regulations and rules therefore as required in the current manual of survey instructions of the United States Department of the Interior, Bureau of Land Management or by a decree of a Court of Law and/or that the corner points mentioned in lines 3, 4 and 5 above were in conformance with the rules of the Michigan Board of Land Surveyors or by a Decree of a Court of Law; established, re-established, monumented, re-monumented, recovered, found as expressed below:

**NOTE: Not more than 4 corners, all in the same town and range, may be recorded on this certificate.**

**A. Description of original monument and accessories and/or subsequent restoration:**

I-4 [1/4 COR COMMON TO SEC'S 10/11] WOOD POST H. MILLEN D.S. 1852 (CEDAR 14°-S9°E-16 LINKS)(CEDAR 16°-N82°E-33 LINKS)  
M.P. DAVIS 1990 - SET 5/8" X 18" IRON PIPE AT JUNCTION OF ANCIENT FENCE LINES E,W,& S. NO WITNESSES LISTED.


I-5 [SE COR SEC 10] WOOD POST H.MILLEN D.S. 1952 (CEDAR 12°-N72°W-12 LINKS)(HEMLOCK 12°-S10°E-17 LINKS)

M.S. MCNABB 1918 - ID ORIGINAL WOOD POST AND WITNESSES - SET IRON MONUMENT IN PLACE OF WOOD POST - BY STAKES (NE 33', SE 33', NW 33', AND S45°W 33')

**B. Description of corner evidence found and/or method applied in restoring or reestablishing corner:**

I-4 [1/4 COR COMMON TO SEC'S 10/11] FOUND THIS DATE DAVIS IRON PIPE. THIS POSITION IS 16.99 FEET NORTH OF MIDPOINT AND IS 0.06 FEET EAST OF A STRAIGHT LINE BETWEEN SEC COR'S NORTE AND SOUTH ACCEPTED EXISTING MONUMENT AS BEING THE BEST AVAILABLE EVIDENCE AS TO THE LOCATION OF THE POSITION OF THE ORIGINAL CORNER.

I-5 [SE COR SEC 10] FOUND THIS DATE MCNABB'S IRON MONUMENT - MATCHES WELL WITH RECORDS OF MCNABB. ACCEPTED EXISTING MONUMENT AS A CAREFUL AND FAITHFUL PERPETUATION OF THE POSITION OF THE ORIGINAL CORNER.

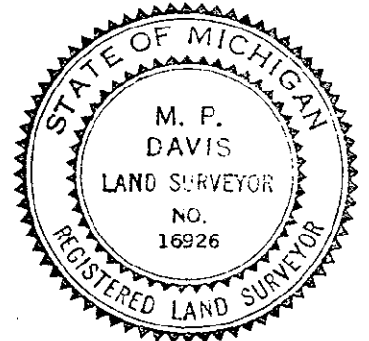

**C. Description of monument for corner and accessories established to perpetuate locating the position of the corner:**

I-4 REPLACED WOOD POST W/A BERNTSEN AINB36 ALUMN MONUMENT W/A 3 1/4" ALUMN CAP STAMPED TO ID THE CORNER POSITION.

CEDAR 11'	MAPLE 8'	MAPLE 12'	CEDAR 5'	SURVEY MONUMENT SIGN POST
N78°W	N30°E	S69°E	S15°E	NORTH
28.10'	35.27'	21.34'	25.43'	1.88 TO FACE

I-5 SET OVER EXISTING MONUMENT A 5/8" X 18" REBAR W/A 3 1/4" ALUMN CAP STAMPED TO ID THE CORNER POSITION & RAISTED TO GRADE W/A MON BOX.

SPRUCE 5'	BALSAM 7'	TAMARACK 6'	SW COR GARAGE	SURVEY MONUMENT SIGN POST
S40°E	S48°W	N24°W	N36°E	NORTH
51.35'	50.05'	60.70'	73.12'	20.95' TO FACE

NOTE: BEARINGS TO REFERENCE OBJECTS ARE MAGNETIC & DISTANCES ARE TO A NAIL W/A REFERENCE TAG UNLESS OTHERWISE NOTED.

Signed by M.P. Davis Date 12/4/97

Surveyor's Michigan License No. 12/4/97 16926