


LAND CORNER RECORDATION CERTIFICATE
 Filing Requirement of Act 74, Mich. P.A. 1970

Robert Schmelzky
 Acting Chairman

For corners in

<u>DELTA</u> (County)	Located In:	Corner Code ##
1. Public Land Survey	T <u>40 N</u> R <u>24 W</u>	 <u>L-3</u>
	T _____ R _____	_____
	T _____ R _____	_____
	T _____ R _____	_____
2. Property Controlling in Section	S _____ T _____ R _____	_____
	S _____ T _____ R _____	_____
3. Miscellaneous Property in Sec.	S _____ T _____ R _____	_____
	S _____ T _____ R _____	_____

MAY 13 1994

Recorded _____
 at 9:00 o'clock AM in Liber 7 Page 407
William C. Thomas
 Reg. of Deeds.
 Delta County, Michigan
 Register of Deeds Stamp & File Number

4. Lot No. _____, Recorded Plat _____
 5. Private Claims _____
K-3 [SW COR SEC 1] L-3 [S1/4 COR SEC 1]

A	B	C	D	E	F	G	H	I	J	K	L	M
2	6	5	4	3	2	1						
3												
4	7	8	9	10	11	12						
5												
6	18	17	16	15	14	13						
7												
8	19	20	21	22	23	24						
9												
10	30	29	28	27	26	25						
11												
12	31	32	33	34	35	36						
13												

I, M.P. DAVIS, in a field survey on MARCH, 1994, do hereby certify that under requirements of P.A. 74, Michigan P.A. of 1970, the corner points mentioned in lines 1 and 2 above were in conformance with regulations and rules therefore as required in the current manual of survey instructions of the United States Department of the Interior, Bureau of Land Management or by a decree of a Court of Law and/or that the corner points mentioned in lines 3, 4 and 5 above were in conformance with the rules of the Michigan Board of Land Surveyors or by a Decree of a Court of Law; established, re-established, monumented, re-monumented, recovered, found as expressed below:


NOTE: Not more than 4 corners, all in the same town and range, may be recorded on this certificate.

A. Description of original monument and accessories and/or subsequent restoration:

- K-3 [SW COR SEC 1] HARVEY MILLEN, D.S. - 1852 - WOOD POST (HEMLOCK 12'-S30°W-38 LINKS) (HEMLOCK 09°-N19°W-10 LINKS)
 1914 -M.S.McNABB, ROAD ALIGNMENT SURVEY FOR CORNELL TWP. - ID COR POSITION FROM IRON STAKE IN HWY -SET BY STAKES N89°E & SW 33'
- L-3 [S1/4 COR SEC 1] HARVEY MILLEN, D.S. - 1852 - WOOD POST - (HEMLOCK 10°-N37°E-14 LINKS) (W.PINE 24'-WEST-12 LINKS)
 1914 -M.S.McNABB, ROAD ALIGNMENT SURVEY FOR CORNELL TWP. - ID CORNER POSITION BY STAKE IN PLACE & BOTH ORIGINALS- SET BY STAKES N & S 33'

B. Description of corner evidence found and/or method applied in restoring or reestablishing corner:

- K-3 [SW COR SEC 1] NO EVIDENCE OF McNABB'S 1914 SURVEY MONUMENT FOUND - RESTORED CORNER POSITION BY RETRACEMENT OF McNABB'S 1914 ROAD ALIGNMENT SURVEY. FOUND S1/4 COR & W1/16 ON S LINE OF SEC 1 & EXTENDED LINE WEST FROM THE S1/4 COR & THRU THE W1/16 COR & SET THE SW COR OF SEC 1 ON THIS LINE AT A PROPORTIONATE DISTANCE WEST OF THE W1/16. ACCEPTED THIS POSITION AS BEING A CAREFUL & FAITHFUL REESTABLISHMENT OF THE POSITION OF THE ORIGINAL CORNER.
- L-3 [S1/4 COR SEC 1] FOUND ROTTED REMAINS OF A WOOD POST IN A STONE MOUND 15" M/L BELOW THE ROAD SURFACE. NO EVIDENCE OF McNABB'S BY STAKES, CORNER MONUMENT COINCIDES WITH ANCIENT OCCUPATION TO THE NORTH. ACCEPTED THIS POSITION AS A CAREFUL & FAITHFUL PERPETUATION OF THE POSITION OF THE ORIGINAL CORNER.

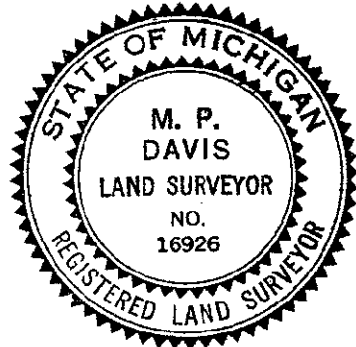

C. Description of monument for corner and accessories established to perpetuate locating the position of the corner:

- K-3 SET, INSIDE A MONUMENT BOX, A 5/8" X 18" REBAR W/A 3-1/4" ALUMN CAP STAMPED TO ID THE CORNER POSITION.
 POWER POLE SURVEY MONUMENT SIGN POST DRILL HOLE IN FIELD STONE SW COR CONC TELE PAD
 N21°W S54°W S51°E N41°E
 53.57' (TO FACE) 39.42' (TO FACE) 41.26' 54.78'
- L-3 SET, 6" M/L BELOW ROAD SURFACE, A 5/8" X 18" REBAR W/A 3-1/4" ALUMN CAP STAMPED TO ID THE CORNER POSITION.
 CEDAR 5" SURVEY MONUMENT SIGN POST CEDAR 5" TAMARACK 6"
 N05°E NORTH S48°W S34°E
 82.20' 18.47' (TO FACE) 69.40' 84.92'

NOTE: BEARINGS TO REFERENCE OBJECTS ARE MAGNETIC & DISTANCES ARE TO A NAIL W/A REFERENCE TAG, UNLESS NOTED OTHERWISE

Signed by M.P. Davis Date 4/4/94
 Surveyor's Michigan License No. 16926