

SURVEY & REMONUMENTATION

OCT 03 2000

SECTION

LAND CORNER RECORDATION CERTIFICATE
Filing Requirement of Act 74, Mich. P.A. 1970

For corners in

DELTA (County)	Located In:	Corner Code #
1. Public Land Survey	T 40 NR 24 W	L-06 ✓
	T 40 NR 24 W	L-07
2. Property Controlling in Section	T R	
	T R	
	S T R	
	S T R	
3. Miscellaneous Property in Sec.	S T R	
	S T R	
	S T R	
	S T R	

L-06 [C1/4 COR SEC 13] L-07 [N1/4 COR SEC 24]

County of Delta
 Registration Act 345 of
 P. 1000000 On July 12, 2000
Robert E. Schmelzer
 Acting Registrar

RECORDED 28 July 2000

AT 9:00 O'CLOCK a.m.

LIBER 9 PAGE 231

William C. Zeman
 DELTA COUNTY MI REG. OF DEEDS

Register of Deeds Stamp & File Number

4. Lot No. _____, Recorded Plat _____
 5. Private Claims _____

I, M.P. DAVIS, in a field survey on JANUARY, 00 do hereby state that under requirements of P.A. 74, Michigan P.A. of 1970, the corner points mentioned in lines 1 and 2 above were in conformance with regulations and rules therefore as required in the current manual of survey instructions of the United States Department of the Interior, Bureau of Land Management or by a decree of a Court of Law and/or that the corner points mentioned in lines 3, 4 and 5 above were in conformance with the rules of the Michigan Board of Land Surveyors or by a Decree of a Court of Law; established, re-established, monumented, recovered, found as expressed below:

NOTE: Not more than 2 corners, all in the same town and range, may be recorded on this certificate.


A	B	C	D	E	F	G	H	I	J	K	L	M
1												
2	6	5	4	3	2	1						
3												
4	7	8	9	10	11	12						
5												
6	18	17	16	15	14	13						
7												
8	19	20	21	22	23	24						
9												
10	30	29	28	27	26	25						
11												
12	31	32	33	34	35	36						
13												

A. Description of original monument and accessories and/or subsequent restoration:

- L-06 [C1/4 COR SEC 13] NOT SET IN ORIGINALS
 M.S.McNABB-1936-SET PUMP POINT AT INTERSECTION OF 1/4 LINES CEDAR STUMP 20" S15°W 38'
- L-07 [N1/4 COR SEC 24] HARVEY MELLEN, D.S.-1852- WOOD POST (B.ASH 10" N79°E 39 LINKS)(B.ASH 10" S45°W 37 LINKS)
 M.S.McNABB-1936-STAKE IN PLACE FROM PREVIOUS SURVEY - BT STAKE NORTH 10' CEDAR STUMP 18" S68°W 58'

B. Description of corner evidence found and/or method applied in restoring or reestablishing corner:

- L-06 [C1/4 COR SEC 13] FOUND IN PLACE, AT THE INTERSECTION OF FENCE LINES E-W & S, A PUMP POINT. ID SAME AS THAT SET BY McNABB FROM HIS CEDAR STUMP BT, NOW DOWN AND IN POOR CONDITION. ACCEPTED EXISTING MONUMENT AS BEING A CAREFUL & FAITHFUL ESTABLISHMENT OF THE COR POSITION.
- L-07 [N1/4 COR SEC 24] NO CORNER EVIDENCE FOUND - REESTABLISHED CORNER POSITION BY EXTENDING A LINE SOUTH FROM THE N1/4 COR THRU THE C1/4 COR OF SEC 13 & REESTABLISHING THE S1/4 CORNER ON THIS LINE AND AT A PROPORTIONATE DISTANCE SOUTH OF THE C1/4 COR, WITH THE PROPORTIONATE DISTANCES BEING BASED ON THE 1936 MEASUREMENTS OF M.S.McNABB. ACCEPTED AS BEING THE BEST AVAILABLE EVIDENCE AS TO THE LOCATION OF THE POSITION OF THE ORIGINAL CORNER.

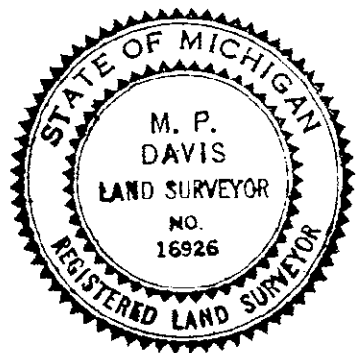

C. Description of monument for corner and accessories established to perpetuate locating the position of the corner:

- L-06 SET, OVER EXISTING MONUMENT, A BERNTSEN A1NB30 ALUM MONUMENT WITH THE CAP STAMPED TO ID THE CORNER POSITION
 MAPLE 05" N21°E 33.15' W.BIRCH 07" N76°E 60.59' BALSAM 06" S25°W 16.73' SURVEY MONUMENT SIGN POST SOUTH 0.69'(TO FACE)
- L-07 SET A 5/8" X 18" REBAR W/A 3-1/4" ALUM CAP STAMPED TO ID THE CORNER POSITION.
 ASPEN 13" N28°W 60.80' ELM 08" N37°E 90.65' ASPEN 06" S51°W 51.00' SURVEY MONUMENT SIGN POST SOUTH 1.75'(TO FACE)

NOTE: BEARINGS TO REFERENCE OBJECTS ARE MAGNETIC-DISTANCES ARE TO A NAIL W/A DELTA COUNTY REFERENCE TAG, UNLESS OTHERWISE NOTED.

Signed by M.P. Davis Date 7/13/00
 Surveyor's Michigan License No. 16926