

FEB 22 1996

COMMISSION

Approved By Delta County
Land Survey Remonumentation
Peer Group Under Act 345 Of
P.A. Of 1990 On Sept 27, 1995
Walter S. Thomas
Chairman

LAND CORNER RECORDATION CERTIFICATE
Filing Requirement of Act 74, Mich. P.A. 1970

For corners in DELTA (County) Located In: Corner Code #

1. Public Land Survey T 41 N R 19 W M-10 M-11
T 41 N R 18 W A-10
T 41 N R 18 W
T 41 N R 18 W

2. Property Controlling S T R
in Section S T R

3. Miscellaneous S T R
Property in Sec. S T R

Recorded OCT - 5 1995
at 9:00 o'clock AM in Liber 8 Page 101
Walter S. Thomas Reg. of Deeds.
Delta County, Michigan

Register of Deeds Stamp & File Number

4. Lot No. , Recorded Plat

5. Private Claims

M-10 [E1/4 COR SEC 25-SAME AS A-10 T41N R18W] M-11 [NE COR SEC 36-SAME AS A-11 T41N R18W]


A	B	C	D	E	F	G	H	I	J	K	L	M
2	6	5	4	3	2	1						
3	7	8	9	10	11	12						
4												
5												
6	18	17	16	15	14	13						
7												
8	19	20	21	22	23	24						
9												
10	30	29	28	27	26	25						
11												
12	31	32	33	34	35	36						
13												

I, M.P. DAVIS, in a field survey on SEPTEMBER, 19 95, do hereby certify that under requirements of P.A. 74, Michigan P.A. of 1970, the corner points mentioned in lines 1 and 2 above were in conformance with regulations and rules therefore as required in the current manual of survey instructions of the United States Department of the Interior, Bureau of Land Management or by a decree of a Court of Law and/or that the corner points mentioned in lines 3, 4 and 5 above were in conformance with the rules of the Michigan Board of Land Surveyors or by a Decree of a Court of Law; established, re-established, monumented, re-monumented, recovered, found as expressed below:

NOTE: Not more than 4 corners, all in the same town and range, may be recorded on this certificate.

- A. Description of original monument and accessories and/or subsequent restoration:
- M-10 [E1/4 COR SEC. 25] JOHN BURT, D.S. - 1845 - (HEMLOCK 14"-S40°E-16 LINKS) (HEMLOCK 13"-N50°W-20 LINKS)
JOSEPH E. GINGRASS - 1906 - RESET FROM ORIGINALS - NO NEW WIT'S NOTED
M.S. McNABB - 1920 - STAKE IN PLACE - NO NEW WIT'S NOTED
 - M-11 [NE COR SEC. 36] JOHN BURT, D.S. - 1845 - WOOD POST (SUGAR 12"-S49°W-49 LINKS) (SUGAR 06"-N51°W-31 LINKS)
A. HERRYWEATHER, D.S. - 1848 - WOOD POST (SUGAR 05" -S30°E-08 LINKS) (SUGAR 12"-N20°E-20 LINKS)
JOSEPH E. GINGRASS - 1906 - ID "FROM ORIGINALS" NO NEW WIT'S NOTED
M.S. McNABB - 1913 - ID FROM "GLO" SW BT - SET IRON STAKE - ELM STUMP 30"-S80°E.-25.4'

- B. Description of corner evidence found and/or method applied in restoring or reestablishing corner:
- M-10 [E1/4 COR SEC 25] FOUND REMAINS OF WOOD POST AT JCT OF ANCIENT FENCE LINES WEST & SOUTH. DISTANCES WEST AND SOUTH TO ADJOINING CORNERS MATCH WELL WITH THE RECORDS OF McNABB & GINGRASS. ACCEPTED THIS POSITION AS BEING A CAREFUL & FAITHFUL PERPETUATION OF THE POSITION OF THE ORIGINAL CORNER.
 - M-11 [NE COR SEC 36] FOUND IN PLACE 1" X 30" IRON PIN & REMAINS OF ELM STUMP WHICH BEARS S80°E 25.4' ACCEPTED EXISTING MONUMENT AS BEING A CAREFUL & FAITHFUL PERPETUATION OF THE POSITION OF THE ORIGINAL CORNER.

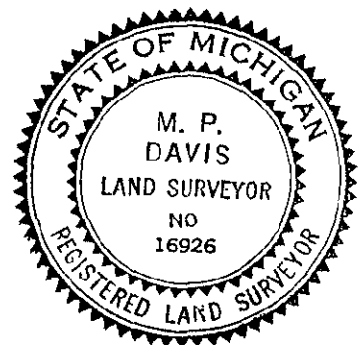

- C. Description of monument for corner and accessories established to perpetuate locating the position of the corner:
- M-10 SET A BERNTSEN AINB30 ALUMN MONUMENT W/A 3 1/4" ALUMN CAP STAMPED TO ID THE CORNER POSITION.
MAPLE 5" MAPLE 7" SPRUCE 7" SPRUCE 8" SURVEY MONUMENT SIGN POST
N51°W S06°E S21°W N71°W SOUTH
14.41' 8.98' 15.18' 37.31' 1.97' (TO FACE)
 - M-9 SET, OVER EXISTING MONUMENT, A BERNTSEN AINB30 ALUMN MONUMENT W/A 3 1/4" ALUMN CAP STAMPED TO ID THE CORNER POSITION.
SURVEY MONUMENT SIGN POST NOTE: FARM FIELDS IN ALL QUADRANTS
EAST NO OTHER WIT'S AVAILABLE
3.80' (TO FACE)

NOTE: BEARINGS TO REFERENCE OBJECTS ARE MAGNETIC-DISTANCES ARE TO A NAIL W/A DELTA COUNTY REFERENCE TAG, UNLESS OTHERWISE NOTED.

Signed by M.P. Davis Date 9/27/95
Surveyor's Michigan License No. 16926