

REMONUMENTATION

FEB 22 1996

COMMISSION

LAND CORNER RECORDATION CERTIFICATE  
Filing Requirement of Act 74, Mich. P.A. 1970

Approved By Delta County  
Land Survey Remonumentation  
Peer Group Under Act 345 Of  
P.A. Of 1990 On Aug 22, 1995

*Walter C. Z...*  
Chairman

For corners in  
DELTA  
(County)

Located In:

Corner Code #

- |                                    |               |             |
|------------------------------------|---------------|-------------|
| 1. Public Land Survey              | T 41 N R 19 W | M-12 M-13   |
|                                    | T 41 N R 18 W | <u>A-12</u> |
| 2. Property Controlling in Section | S T R         |             |
| 3. Miscellaneous Property in Sec.  | S T R         |             |
| 4. Lot No. _____, Recorded Plat    |               |             |
| 5. Private Claims                  |               |             |

Recorded OCT - 5 1995

at 9:00 o'clock AM in Liber 8 Page 102

*Walter C. Z...* Reg. of Deeds.  
Delta County, Michigan

Register of Deeds Stamp & File Number

M-12 [E1/4 COR SEC 36-SAME AS A-12 T41N R18W] M-13 [SE COR SEC 36-SAME AS A-13 T41N R18W]

I, M.P. DAVIS, in a field survey on SEPTEMBER, 19 95, do hereby certify that under requirements of P.A. 74, Michigan P.A. of 1970, the corner points mentioned in lines 1 and 2 above were in conformance with regulations and rules therefore as required in the current manual of survey instructions of the United States Department of the Interior, Bureau of Land Management or by a decree of a Court of Law and/or that the corner points mentioned in lines 3, 4 and 5 above were in conformance with the rules of the Michigan Board of Land Surveyors or by a Decree of a Court of Law; established, re-established, monumented, re-monumented, recovered, found as expressed below:

A	B	C	D	E	F	G	H	I	J	K	L	M
2	6	5	4	3	2	1						
3	7	8	9	10	11	12						
4												
5												
6	18	17	16	15	14	13						
7												
8	19	20	21	22	23	24						
9												
10	30	29	28	27	26	25						
11												
12	31	32	33	34	35	36						
13												

NOTE: Not more than 4 corners, all in the same town and range, may be recorded on this certificate.

A. Description of original monument and accessories and/or subsequent restoration:


M-12 [E1/4 COR SEC. 36] JOHN BURT, D.S. - 1845 - (TAMARACK 24"-S67°W-06 LINKS) (HEMLOCK 05"-N47°W-17 LINKS)  
NO RECORD EVIDENCE OF CORNER RECOVERY OF SUBSEQUENT MONUMENTATION

M-13 [SE COR SEC. 36] JOHN BURT, D.S. - 1845 - WOOD POST (HEMLOCK 14"-N40°E-09 LINKS) (HEMLOCK 15"-S59°W-20 LINKS)  
M.S. McNABB - 1920 - ESTABLISHED ON 4TH CORRECTION LINE IN LINE WITH FARM FENCE NORTH. NO WIT'S NOTED, SET IRON STAKE.

B. Description of corner evidence found and/or method applied in restoring or reestablishing corner:

M-12 [E1/4 COR SEC 36] FOUND IN PLACE A 2" X 30" GALV IRON PIPE AT JCT OF FARM FENCES NORTH AND WEST. NO OTHER EVIDENCE OF CORNER POSITION FOUND, ACCEPTED EXISTING MONUMENT AS BEING THE BEST AVAILABLE EVIDENCE AS TO THE POSITION OF THE ORIGINAL CORNER.

M-13 [SE COR SEC 36] FOUND IN PLACE 3/4" IRON PIPE. CORNER POSITION FALL IN AN OPEN FARM FIELD, NO OTHER EVIDENCE AVAILABLE, DISTANCES E & W TO ADJOINING CORNERS CHECK WELL WITH THE RECORD. ACCEPTED EXISTING MONUMENT AS THE BEST AVAILABLE EVIDENCE AS TO THE LOCATION OF THE POSITION OF THE ORIGINAL CORNER.

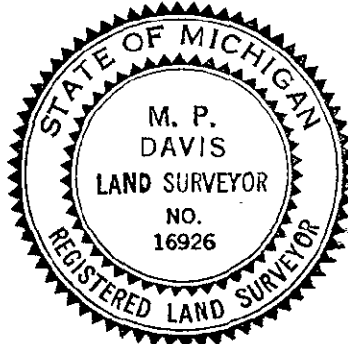

C. Description of monument for corner and accessories established to perpetuate locating the position of the corner:

M-12 REPLACED EXISTING MONUMENT W/A BERNTSEN A1NB30 ALUMN MONUMENT W/A 3 1/4" ALUMN CAP STAMPED TO ID THE CORNER POSITION.  
MAPLE 24" CEDAR 11" SURVEY MONUMENT SIGN POST NOTE: FARM FIELDS IN NE & SE QUADRANTS  
S40°W N25°W WEST NO OTHER WIT'S AVAILABLE.  
36.57' 56.53' 2.12' (TO FACE)

M-13 SET, OVER EXISTING MON, A BERNTSEN A1NB30 ALUMN MONUMENT W/A 3 1/4" ALUMN CAP STAMPED TO ID THE CORNER POSITION.  
SURVEY MONUMENT SIGN POST NOTE: FARM FIELDS IN ALL QUADRANTS  
SOUTH NO OTHER WIT'S AVAILABLE  
2.35' (TO FACE)

NOTE: BEARINGS TO REFERENCE OBJECTS ARE MAGNETIC-DISTANCES ARE TO A NAIL W/A DELTA COUNTY REFERENCE TAG, UNLESS OTHERWISE NOTED.

Signed by M.P. Davis

Date 9/27/95

Surveyor's Michigan License No. 16926