

**SURVEY & REMONUMENTATION**

**JAN 14 1998**

**SECTION**

**LAND CORNER RECORDATION CERTIFICATE**  
Filing Requirement of Act 74, Mich. P.A. 1970

Approved By Delta County  
Land Survey Remonumentation  
Peer Group Under Act 345 Of  
P.A. Of 1990 On 12/18, 1992  
*R. E. Schmeling*  
Acting Chairman

For corners in

DELTA

(County)

Located In:

Corner Code ##

1. Public Land Survey	T	41	NR	23	W	M-05 & M-07
	T	41	NR	22	W	A-05 & A 07
	T		R			SAME CORNERS
	T		R			
2. Property Controlling in Section	S		T		R	
	S		T		R	
3. Miscellaneous Property in Sec.	S		T		R	
	S		T		R	

Dec 19 1997  
9:00 AM  
290

*Walter C. Thomas*

Register of Deeds Stamp & File Number

4. Lot No. \_\_\_\_\_, Recorded Plat \_\_\_\_\_  
5. Private Claims M-05 NE COR SEC 13 M-07 NE COR SEC 24


A	B	C	D	E	F	G	H	I	J	K	L	M
2	6	5	4	3	2	1						
3												
4	7	8	9	10	11	12						
5												
6	18	17	16	15	14	13						
7												
8	19	20	21	22	23	24						
9												
10	30	29	28	27	26	25						
11												
12	31	32	33	34	35	36						
13												

I, M.P. DAVIS, in a field survey on 10 MARCH, 1997, do hereby certify that under requirements of P.A. 74, Michigan P.A. of 1970, the corner points mentioned in lines 1 and 2 above were in conformance with regulations and rules therefore as required in the current manual of survey instructions of the United States Department of the Interior, Bureau of Land Management or by a decree of a Court of Law and/or that the corner points mentioned in lines 3, 4 and 5 above were in conformance with the rules of the Michigan Board of Land Surveyors or by a Decree of a Court of Law; established, re-established, monumented, re-monumented, recovered, found as expressed below:

**NOTE: Not more than 4 corners, all in the same town and range, may be recorded on this certificate.**

- A. Description of original monument and accessories and/or subsequent restoration:  
 M-05 [NE COR SEC 13] JOHN BURT D.S.-1845-WOOD POST (SUGAR 06"-S66°W-14 LINKS)(SUGAR 10"-N16°W-26 LINKS) A.MERRYWEATHER, D.S.-1847-CORNER IN PLACE (SUGAR 10"-S53°E-19 LINKS)(SUGAR 14"-N18°E-22 LINKS) PARK SAWYER-1918-ID BY ORIGINALS - SET IRON PIN (NO NEW WIT'S NOTED) R.E.SCHMELING-1965-REC'D. L.4 PG.10-SET 1 1/2" X 42' IRON ROD (MAPLE 14"-N24°W-64.7')(MAPLE 12"-N56°E-59.5')  
 M-07 [NE COR SEC 24] JOHN BURT D.S.-1845-WOOD POST (CEDAR 16"-S50°W-25 LINKS)(CEDAR 16"-N57°W-29 LINKS) PARK SAWYER-1918-NO CORNER TO BE FOUND-ESTABLISHED ON TRUE RANGE LINE & PROPORTIONAL DISTANCE BETWEEN NE COR SEC 13 & SE COR SEC 25, SET IRON PIN (BALSAM 09'-S56°W-14')(W.BIRCH 09"-N12°W-19.8')

- B. Description of corner evidence found and/or method applied in restoring or reestablishing corner:  
 M-05 [NE COR SEC 13] RECOVERED MONUMENT AS SET BY R.E.SCHMELING IN 1965 & AS DESCRIBED IN L.4 PG. 10 ID EXISTING MONUMENT FROM SCHMELING'S NE MAPLE BT (STILL GREEN). ACCEPTED EXISTING AS BEING A CAREFUL & FAITHFUL REESTABLISHMENT OF THE POSITION OF THE ORIGINAL CORNER.  
 M-07 [NE COR SEC 24] RECOVERED, AT ANCIENT FENCE CORNER, A 1" SOLID IRON PIN, NO EVIDENCE OF SAWYER'S 1918 BT'S. EXISTING MONUMENT CHECKS WELL FOR ALIGNMENT & PROPORTIONAL DISTANCE BETWEEN THE NE COR OF SEC 13 & SE COR OF SEC 25 T41N R23W. ACCEPTED EXISTING MONUMENT AS BEING A CAREFUL AND FAITHFUL REESTABLISHMENT OF THE POSITION OF THE ORIGINAL CORNER.

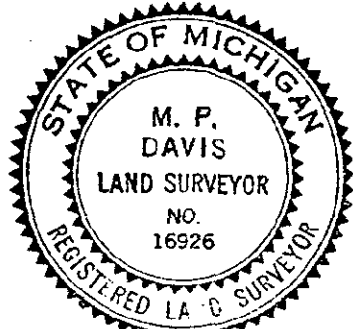

- C. Description of monument for corner and accessories established to perpetuate locating the position of the corner:  
 M-05 SET OVER EXISTING MONUMENT A 5/8" X 18" REBAR W/A 3 1/4" ALUM CAP STAMPED TO ID THE CORNER POSITION.  
 MAPLE 13"    Y.BIRCH 07"    MAPLE 06"    POWER POLE    SURVEY MONUMENT SIGN POST  
 N43°W    N48°E    S58°E    S42°W    EAST  
 80.46'    34.65'    25.83'    50.76'    12.49' (TO FACE)  
 M-07 SET OVER EXISTING MONUMENT A BERNTSEN A1NB30 ALUM MON W/A 3 1/4" ALUM CAP STAMPED TO ID THE CORNER POSITION.  
 BASSWOOD 05"    MAPLE 07"    C/L ELECTRIC TRANSMISSION LINE    SURVEY MONUMENT SIGN POST  
 N57°E    S20°W    NORTH    S45°E  
 12.59'    21.77'    38'    1.48'

NOTE: BEARINGS TO REFERENCE OBJECTS ARE MAGNETIC & DISTANCES ARE TO A NAIL IN THE CENTER OF THE OBJECT, UNLESS OTHERWISE NOTED.

Signed by M.P. Davis Date 11/27/97  
Surveyor's Michigan License No. 16926