

SURVEY & REMONUMENTATION

JAN 14 1998

SECTION

LAND CORNER RECORDATION CERTIFICATE
Filing Requirement of Act 74, Mich. P.A. 1970

Approved By Delta County
 Land Survey Remonumentation
 Peer Group Under Act 345 Of
 P.A. Of 1990 On 12/18, 1992
Walter C. Thorne
 Acting Chairman

For corners in

DELTA

(County)

Located In:

Corner Code #

- | | | | | |
|------------------------------------|---|--------------|-------------|------------------------|
| 1. Public Land Survey | T | <u>41</u> NR | <u>23</u> W | <u>M-08 & M-09</u> |
| | T | <u>41</u> NR | <u>22</u> W | <u>A-08 & A-09</u> |
| | T | ___ R | ___ | <u>SAME CORNERS</u> |
| | T | ___ R | ___ | ___ |
| 2. Property Controlling in Section | S | ___ T | ___ R | ___ |
| | S | ___ T | ___ R | ___ |
| 3. Miscellaneous Property in Sec. | S | ___ T | ___ R | ___ |
| | S | ___ T | ___ R | ___ |

Dec 19 1997
9:00 AM
8 289
Walter C. Thorne
 Delta County Reg. - Deeds

Register of Deeds Stamp & File Number

4. Lot No. _____, Recorded Plat _____
5. Private Claims M-08 E1/4 COR SEC 24 M-09 NE COR SEC 25


	A	B	C	D	E	F	G	H	I	J	K	L	M
2	6		5		4		3		2		1		
3													
4	7		8		9		10		11		12		
5													
6	18		17		16		15		14		13		
7													
8	19		20		21		22		23		24		
9													
10	30		29		28		27		26		25		
11													
12	31		32		33		34		35		36		
13													

I, M.P. DAVIS, in a field survey on 10 MARCH, 19 97, do hereby certify that under requirements of P.A. 74, Michigan P.A. of 1970, the corner points mentioned in lines 1 and 2 above were in conformance with regulations and rules therefore as required in the current manual of survey instructions of the United States Department of the Interior, Bureau of Land Management or by a decree of a Court of Law and/or that the corner points mentioned in lines 3, 4 and 5 above were in conformance with the rules of the Michigan Board of Land Surveyors or by a Decree of a Court of Law; established, re-established, monumented, re-monumented, recovered, found as expressed below:

NOTE: Not more than 4 corners, all in the same town and range, may be recorded on this certificate.

- A. Description of original monument and accessories and/or subsequent restoration:
- M-08 [E1/4 COR SEC 24] JOHN BURT D.S.-1845-WOOD POST (CEDAR 08°-S65°W-09 LINKS)(CEDAR 10°-N75°W-14 LINKS) PARK SAWYER-1918-NO CORNER TO BE FOUND-ESTABLISHED ON TRUE RANGE LINE & PROPORTIONAL DISTANCE BETWEEN THE NE COR OF SEC 13 & SE COR OF SEC 25 T41N R23W-SET IRON PIN (BALSAM 05°-S72°W-21.4')(W.PINE STUB 30°-N54°E-32.3')
- M-09 [NE COR SEC 25] JOHN BURT D.S.-1345-WOOD POST (CEDAR 05°-S41°W-34 LINKS)(CEDAR 09°-N78°W-26- LINKS) PARK SAWYER-1918-NO CORNER TO BE FOUND-ESTABLISHED ON TRUE RANGE LINE & PROPORTIONAL DISTANCE BETWEEN THE NE COR OF SEC 13 & SE COR OF SEC 25 T41N R23W-SET IRON PIN (BALSAM 07°-S71°W-17.3')(BALSAM 10°-S81°E-18.6')

- B. Description of corner evidence found and/or method applied in restoring or reestablishing corner:
- M-08 [E1/4 COR SEC 24] FOUND IN PLACE & IN APPROX C/L OF E-W COUNTY RD A 5/8" X 15" IRON PIN. SAWYER'S PINE STUB WAS FOUND & OUT OF THE GROUND, APPARENTLY FROM DITCHING OPERATIONS FOR THE COUNTY ROAD. EXISTING MONUMENT CHECKS WELL FOR ALIGNMENT & PROPORTIONAL DISTANCE BETWEEN THE NE COR OF SEC 13 & THE SE COR OF SEC 25 T41N R23W. ACCEPTED EXISTING MONUMENT AS BEING A CAREFUL AND FAITHFUL REESTABLISHMENT OF THE POSITION OF THE ORIGINAL CORNER.
- M-09 [NE COR SEC 25] FOUND IN PLACE AN IRON BOLT, NO EVIDENCE OF PARK SAWYER'S 1918 BT'S FOUND. EXISTING MONUMENT CHECKS WELL FOR ALIGNMENT & PROPORTIONAL DISTANCE BETWEEN THE NE COR OF SEC 13 & SE COR OF SEC 25 T41N R23W. ACCEPTED EXISTING MONUMENT AS BEING A CAREFUL & FAITHFUL REESTABLISHMENT OF THE POSITION OF THE ORIGINAL CORNER.

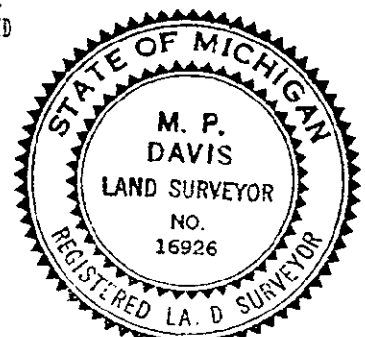

- C. Description of monument for corner and accessories established to perpetuate locating the position of the corner:
- M-08 SET, OVER EXISTING MONUMENT, A 5/8" X 18" REBAR W/A 3/4" ALUM CAP STAMPED TO ID THE CORNER POSITION.
- | | | | | |
|------------|------------|-----------|-----------|---------------------------|
| SPRUCE 12" | SPRUCE 18" | MAPLE 06' | MAPLE 05" | SURVEY MONUMENT SIGN POST |
| N43°W | N12°E | S26°E | S38°W | SOUTH |
| 28.50' | 51.30' | 40.48' | 37.43' | 29.50' (TO FACE) |
- M-09 SET, OVER EXISTING MONUMENT, A BERNTSEN AINB30 ALUM MON W/A 3/4" ALUM CAP STAMPED TO ID THE CORNER POSITION.
- | | | | |
|------------|------------|--------------|---------------------------|
| SPRUCE 12" | SPRUCE 09" | W.CHERRY 07" | SURVEY MONUMENT SIGN POST |
| N18°W | N68°E | N84°W | S45°E |
| 52.12' | 16.04' | 32.83' | 1.54' (TO FACE) |

NOTE: BEARINGS TO REFERENCE OBJECTS ARE MAGNETIC & DISTANCES ARE TO A NAIL IN THE CENTER OF THE OBJECT, UNLESS OTHERWISE NOTED.

Signed by M.P. Davis Date 1/28/97
 Surveyor's Michigan License No. 16926