

SURVEY & REMONUMENTATION

NOV 25 1998

SECTION

LAND CORNER RECORDATION CERTIFICATE
Filing Requirement of Act 74, Mich. P.A. 1970

Approved By Delta County
Land Survey Remonumentation
Peer Group Under Act 345 Of
P.A. Of 1990 On June 26, 1998
Robert L. Laveling
Acting Chairman

For corners in
DELTA
(County)

Located In: Corner Code #

1. Public Land Survey	T	41 N R 22 W	B-08 & B-09
	T	_____ R _____	_____
	T	_____ R _____	_____
	T	_____ R _____	_____
2. Property Controlling in Section	S	_____ T _____ R _____	_____
	S	_____ T _____ R _____	_____
3. Miscellaneous Property in Sec.	S	_____ T _____ R _____	_____
	S	_____ T _____ R _____	_____

Recorded July 7 1998
at 9:00 o'clock AM
by 9 of 90
Walker C. Thoman
Deputy Registrar

Register of Deeds Stamp & File Number

4. Lot No. _____, Recorded Plat _____
5. Private Claims B-08 [C1/4 SEC 18] B-09 [N1/4 SEC 30]

A	B	C	D	E	F	G	H	I	J	K	L	M
2	6	5	4	3	2	1						
3												
4	7	8	9	10	11	12						
5												
6	18	17	16	15	14	13						
7												
8	●	20	21	22	23	24						
9	●											
10	30	29	28	27	26	25						
11												
12	31	32	33	34	35	36						
13												

I, M.P. DAVIS, in a field survey on JULY 1 & 6, 19 98, do hereby certify that under requirements of P.A. 74, Michigan P.A. of 1970, the corner points mentioned in lines 1 and 2 above were in conformance with regulations and rules therefore as required in the current manual of survey instructions of the United States Department of the Interior, Bureau of Land Management or by a decree of a Court of Law and/or that the corner points mentioned in lines 3, 4 and 5 above were in conformance with the rules of the Michigan Board of Land Surveyors or by a Decree of a Court of Law; established, re-established, monumented, re-monumented, recovered, found as expressed below:

NOTE: Not more than 4 corners, all in the same town and range, may be recorded on this certificate.

A. Description of original monument and accessories and/or subsequent restoration:


B-08 [C1/4 COR SEC 19] NOT SET IN ORIGINALS
M.S.McNABB-1927-SET PUMP POINT AT INTERSECTION OF 1/4 LINES. FENCE POST S6°E 59.5'

B-09 [N1/4 COR SEC 30] A.MERRYWEATHER, DS - 1847 - WOOD POST - (BURNT CEDAR 06°-N18°W-10 LINKS)(BURNT CEDAR 05°-S37°E-08 LINKS)
M.S.McNABB-1927-NO CORNER EVIDENCE FOUND. SET WOOD POST AT PROPORTIONATE DISTANCE BETWEEN SEC CORNERS E & W. SPRUCE 7° S60°E 7.87'

B. Description of corner evidence found and/or method applied in restoring or reestablishing corner:

B-08 [C1/4 COR SEC 19] FOUND IN PLACE A PUMP POINT, NO EVIDENCE OF McNABB'S FENCE POST BT TO BE FOUND. CHECKS TO THE E & W AND N & S 1/4 CORNERS REVEAL THE PUMP POINT TO BE VERY NEARLY AT THE INTERSECTION OF THE 1/4 LINES. ACCEPTED EXISTING MONUMENT AS FOUND.

B-09 [N1/4 COR SEC 30] FOUND IN PLACE A 2 1/4" IRON PIPE WITH 1/4" WELDED THEREON. NO EVIDENCE OF McNABB'S WOOD POST OR SPRUCE BT FOUND, THE SE QUADRANT HAS RECENTLY BEEN CLEAR CUT. CHECK TO SEC CORNERS 1/2 MILE EAST & WEST CHECKS VERY WELL WITH THE RECORDS OF McNABB. ACCEPTED EXISTING MONUMENT AS BEING A CAREFUL & FAITHFULL REESTABLISHMENT OF THE POSITION OF THE ORIGINAL CORNER.

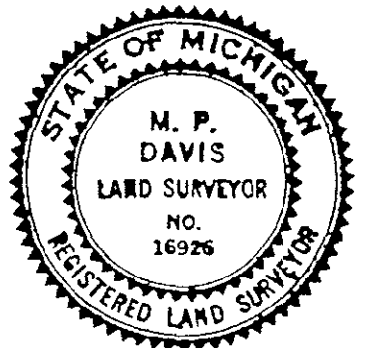

C. Description of monument for corner and accessories established to perpetuate locating the position of the corner:

B-08 SET OVER THE EXISTING MONUMENT A BERNTSEN A1NB30 ALUM MONUMENT WITH THE CAP STAMPED TO ID THE COR POSITION.

ASPEN 10"	ASPEN 05"	SURVEY MONUMENT SIGN POST	C/L OF E-W COUNTY ROAD
N57°W	N50°E	SOUTH	NORTH
8.48'	38.71'	1.15'	36'

B-09 REPLACED EXISTING MONUMENT W/A A BERNTSEN A1NB30 ALUM MONUMENT WITH THE CAP STAMPED TO ID THE CORNER POSITION.

SPRUCE 08"	SPRUCE 07"	MAPLE 12"	SURVEY MONUMENT SIGN POST
N85°W	N23°W	S48°E	SOUTH
33.65'	26.12'	41.05'	0.90' (TO FACE)

NOTE: BEARINGS TO REFERENCE OBJECTS ARE MAGNETIC & DISTANCES ARE TO A NAIL IN THE CENTER OF THE OBJECT UNLESS OTHERWISE NOTED.

Signed by M.P. Davis Date 7/7/98
Surveyor's Michigan License No. 16926