

**SURVEY & REMONUMENTATION**

NOV 25 1998

**SECTION**

**LAND CORNER RECORDATION CERTIFICATE**  
Filing Requirement of Act 74, Mich. P.A. 1970

Approved By Delta County  
Land Survey Remonumentation  
Peer Group Under Act 345 Of  
P.A. Of 1990 On June 26, 1998  
*Robert Holmberg*  
Acting Chairman

For corners in  
DELTA  
(County)

Located In: Corner Code #

- |                                    |                             |                        |
|------------------------------------|-----------------------------|------------------------|
| 1. Public Land Survey              | T <u>41</u> N R <u>22</u> W | <u>C-06 &amp; C-07</u> |
|                                    | T _____ R _____             | _____                  |
|                                    | T _____ R _____             | _____                  |
|                                    | T _____ R _____             | _____                  |
| 2. Property Controlling in Section | S _____ T _____ R _____     | _____                  |
|                                    | S _____ T _____ R _____     | _____                  |
| 3. Miscellaneous Property in Sec.  | S _____ T _____ R _____     | _____                  |
|                                    | S _____ T _____ R _____     | _____                  |

Recorded July 7 1998  
at 9:00 o'clock AM  
Lib. 9 Page 91  
Walter C. Thorne  
Delta County Reg. of Deeds

Register of Deeds Stamp & File Number

4. Lot No. \_\_\_\_\_, Recorded Plat \_\_\_\_\_  
5. Private Claims C-06 [W1/4 COR S.17] C-07 [NW S. 20]


A	B	C	D	E	F	G	H	I	J	K	L	M
2	6	5	4	3	2	1						
3												
4	7	8	9	10	11	12						
5												
6	18	17	16	15	14	13						
7												
8	19	20	21	22	23	24						
9												
10	30	29	28	27	26	25						
11												
12	31	32	33	34	35	36						
13												

I, M.P. DAVIS, in a field survey on JULY 6, 19 98, do hereby certify that under requirements of P.A. 74, Michigan P.A. of 1970, the corner points mentioned in lines 1 and 2 above were in conformance with regulations and rules therefore as required in the current manual of survey instructions of the United States Department of the Interior, Bureau of Land Management or by a decree of a Court of Law and/or that the corner points mentioned in lines 3, 4 and 5 above were in conformance with the rules of the Michigan Board of Land Surveyors or by a Decree of a Court of Law; established, re-established, monumented, re-monumented, recovered, found as expressed below:

**NOTE: Not more than 4 corners, all in the same town and range, may be recorded on this certificate.**

- A. Description of original monument and accessories and/or subsequent restoration:  
C-06 [W1/4 COR SEC 17] A.MERRYWEATHER, DS - 1847 - WOOD POST - (BURNT HEMLOCK 08°-N19°W-21 LINKS)(BURNT BIRCH 06°-S15°E-11 LINKS)  
NO RECORD EVIDENCE OF CORNER RECOVERY AND/OR SUBSEQUENT CORNER MONUMENTATION  
C-07 [NW COR SEC 20] A.MERRYWEATHER, DS - 1847 - WOOD POST - (BURNT CEDAR 09°-S59°E-16 LINKS)(BURNT TAMARACK 14°-N50°W-43 LINKS)  
NO RECORD EVIDENCE OF CORNER RECOVERY AND/OR SUBSEQUENT CORNER MONUMENTATION.

- B. Description of corner evidence found and/or method applied in restoring or reestablishing corner:  
C-06 [W1/4 COR SEC 17] NO ACCEPTABLE CORNER EVIDENCE FOUND. ESTABLISHED CORNER POSITION AT THE MIDPOINT BETWEEN SEC CORNERS 1/2 MILES NORTH AND SOUTH AS PER DIRECTION OF THE DELTA COUNTY PEER GROUP AT A MEETING HELD ON 6/26/98. FROM WHICH A WOOD POST WAS FOUND 8.86' SOUTH AND 35.10' EAST AND AN AXEL SHAFT WAS FOUND 80.60' NORTH & 36.78' EAST. NO RECORD EVIDENCE AS TO THE ORIGIN OF THESE MONUMENTS.  
C-07 [NW COR SEC 20] NO CORNER EVIDENCE FOUND. REESTABLISHED THE CORNER POSITION BY DOUBLE PROPORTIONATE DISTANCE BETWEEN CORNERS 1/2 MILE WEST, 1/2 MILE EAST, 1 MILE NORTH & 1/2 MILE SOUTH.

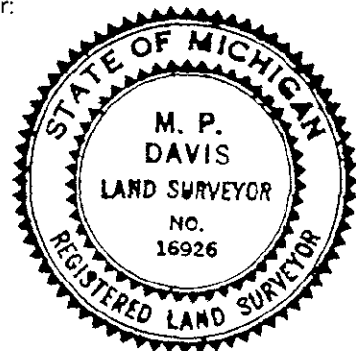

- C. Description of monument for corner and accessories established to perpetuate locating the position of the corner:  
C-06 SET A BERNTSEN A1NB30 ALUM MONUMENT WITH THE CAP STAMPED TO ID THE CORNER POSITION.  
BALSAM 05° N72°W 15.83'  
BALSAM 07° N45°E 16.35'  
BALSAM 06° S39°E 12.80'  
BALSAM 08° S47°W 28.09'  
SURVEY MONUMENT SIGN POST SOUTH 2.22' (TO FACE)  
C-07 SET A BERNTSEN A1NB30 ALUM MONUMENT WITH THE CAP STAMPED TO ID THE CORNER POSITION.  
BALSAM 04° N73°W 25.42'  
SPRUCE 16° N44°E 23.45'  
MAPLE 05° S26°E 36.15'  
BALSAM 05° S39°W 22.80'  
SURVEY MONUMENT SIGN POST SOUTH 1.80' (TO FACE)

NOTE: BEARINGS TO REFERENCE OBJECTS ARE MAGNETIC & DISTANCES ARE TO A NAIL W/A REFERENCE TAG UNLESS OTHERWISE NOTED.

Signed by M.P. DAVIS Date 7/7/98  
Surveyor's Michigan License No. 16926