

**SURVEY & REMONUMENTATION**

**JAN 14 1998**

**SECTION**

**LAND CORNER RECORDATION CERTIFICATE**  
Filing Requirement of Act 74, Mich. P.A. 1970

Approved By Delta County  
Land Survey Remonumentation  
Peer Group Under Act 345 Of  
P.A. Of 1990 On 12/18, 1992  
*Robert J. ...*  
Chairman

For corners in  
DELTA  
(County)

Located In: Corner Code #

- 1. Public Land Survey T 41 N R 22 W C-08 & C-09
- T \_\_\_\_\_ R \_\_\_\_\_
- T \_\_\_\_\_ R \_\_\_\_\_
- T \_\_\_\_\_ R \_\_\_\_\_
- 2. Property Controlling S \_\_\_\_\_ T \_\_\_\_\_ R \_\_\_\_\_
- in Section S \_\_\_\_\_ T \_\_\_\_\_ R \_\_\_\_\_
- 3. Miscellaneous S \_\_\_\_\_ T \_\_\_\_\_ R \_\_\_\_\_
- Property in Sec. S \_\_\_\_\_ T \_\_\_\_\_ R \_\_\_\_\_

Dec 19 1997  
9:00 AM  
8  
Register of Deeds Stamp & File Number

- 4. Lot No. \_\_\_\_\_, Recorded Plat \_\_\_\_\_
- 5. Private Claims C-08 [W1/4 COR S.20] C-09 [NW S. 29]

	A	B	C	D	E	F	G	H	I	J	K	L	M
2	6	5	4	3	2	1							
3													
4	7	8	9	10	11	12							
5													
6	18	17	16	15	14	13							
7													
8	19	20	21	22	23	24							
9													
10	30	29	28	27	26	25							
11													
12	31	32	33	34	35	36							
13													

I, M.P. DAVIS, in a field survey on OCTOBER 05, 19 97, do hereby certify that under requirements of P.A. 74, Michigan P.A. of 1970, the corner points mentioned in lines 1 and 2 above were in conformance with regulations and rules therefore as required in the current manual of survey instructions of the United States Department of the Interior, Bureau of Land Management or by a decree of a Court of Law and/or that the corner points mentioned in lines 3, 4 and 5 above were in conformance with the rules of the Michigan Board of Land Surveyors or by a Decree of a Court of Law; established, re-established, monumented, re-monumented, recovered, found as expressed below.


**NOTE: Not more than 4 corners, all in the same town and range, may be recorded on this certificate.**

**A. Description of original monument and accessories and/or subsequent restoration:**

- C-08 [W1/4 COR SEC 20] A.MERRYWEATHER, DS - 1847 - WOOD POST - (HEMLOCK 14°-S51°E-44 LINKS)(Y.PINE 40°-WEST-12 LINKS)  
M.S.McNABB-1919-ID COR FROM STAKE IN PLACE & BT STAKES NW & SE 33'-SET IRON PIPE FROM WHICH COR FENCE POST N40°E-23.7'  
T.O'BRIEN-1979-SET FROM PRIOR SURVEY OF RECORD-SET IRON BAR & CAP (PP N45°W-45.6)(FENCE POST S60°W-52.9') REC'D. LIBER 2 PG 252
- C-09 [NW COR SEC 29] A.MERRYWEATHER, DS - 1847 - WOOD POST - (BALM OF GILEAD 14°-S62°E-30 LINKS)(CEDAR 09°-S70°W-67 LINKS)  
M.S.McNABB-1919-"ESTABLISHED FROM IMPROVEMENTS" NO DESCRIPTION OF MONUMENT SET OR BT'S NOTED  
M.S.McNABB-1927-FROM PREVIOUS SURVEY-SET IRON PIPE-FENCE POST S88°E-25.8'  
T.O'BRIEN-1979-FOUND IRON BAR-FENCE CORNERS S50°W-32.1' & EAST-26.9'

**B. Description of corner evidence found and/or method applied in restoring or reestablishing corner:**

- C-08 [W1/4 COR SEC 20] FOUND IN PLACE 1/2" X 18" IRON BAR W/A SURVEY CAP O'BRIEN WIT'S HAVE BEEN DESTROYED AND/OR REMOVED. CHECKED EAST FROM W1/4 COR SEC 19 THRU C1/4 (McNABB'S PUMP POINT) TO O'BRIEN CORNER WHICH CHECKS GOOD FOR ALIGNMENT & PROPORTIONAL TO McNABB'S 1919 MEASUREMENT OF THE E-W1/4 LINE OF SEC 19. ACCEPTED AS BEING THE BEST AVAILABLE EVIDENCE AS TO THE POSITION OF THE ORIGINAL CORNER.
- C-09 [NW COR SEC 29] FOUND IN PLACE & 2' BELOW ROAD SURFACE, A 3/4" IRON PIPE (DESCRIBED BY O'BRIEN AS AN IRON BAR) ID FROM REMAINS OF CORNER FENCE POST (O'BRIEN EAST-26.9')(McNABB S88°E-25.8') ACCEPTED EXISTING MONUMENT AS BEING THE BEST AVAILABLE EVIDENCE AS TO THE LOCATION OF THE POSITION OF THE ORIGINAL CORNER.

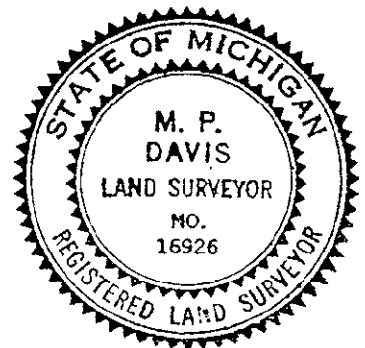

**C. Description of monument for corner and accessories established to perpetuate locating the position of the corner:**

- C-08 REPLACED EXISTING MON W/A 5/8" X 18" REBAR WITH A 3 1/4" ALUM CAP STAMPED TO ID THE CORNER POSITION & RAISED TO GRADE W/A MON BOX.  

TAMARACK 08"	POWER POLE	CUT NOTCH S END CMP	SURVEY MONUMENT SIGN POST
S60°W	N40°W	S22°E	N47°E
59.60'	46.75'	46.95'	29.62' (TO FACE)
- C-09 SET OVER EXISTING MON A 5/8" X 18" REBAR W/A 3 1/4" ALUM CAP STAMPED TO ID THE CORNER POSITION & RAISED TO GRADE W/A MON BOX  

ELM 03"	ELM 06"	FENCE POST	SURVEY MONUMENT SIGN POST
N74°E	S74°E	S46°W	EAST
25.62'	27.37'	37.28'	17.70' (TO FACE)

NOTE: BEARINGS TO REFERENCE OBJECTS ARE MAGNETIC & DISTANCES ARE TO A NAIL W/A REFERENCE TAG UNLESS OTHERWISE NOTED.

Signed by M.P. Davis 11/21/97 Date 11/21/97  
Surveyor's Michigan License No. 16926